


I:\25\2010\_44713\_PM\_VA\B53\active\B53002A\transportation\drawings\contract\_4\pilot\_files\26307c4pro-279EB.pptf

**NOTE:**  
 ELEVATIONS SHOWN TO THE NEAREST HUNDREDTH ARE EXISTING GROUND.  
 ELEVATIONS SHOWN TO THE NEAREST THOUSANDTH ARE FINISH GRADE.

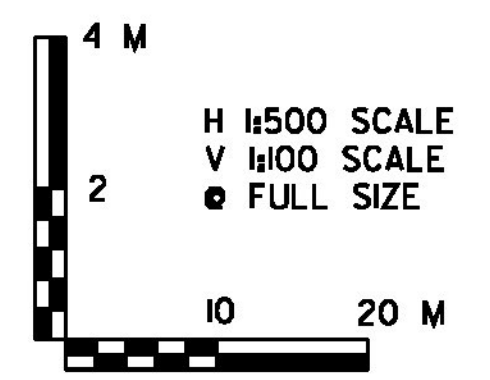

	PROJECT NAME: BENNINGTON	PLOT DATE: 1/26/2010
	PROJECT NUMBER: NH 019-1(54)	DRAWN BY: STANTEC
FILE NAME: ..\zd307c4pro.279EB.pptf	DESIGNED BY: MARC FOISY	CHECKED BY: GARY SANTY
DESIGN SUPERVISOR: GREG EDWARDS	VT ROUTE 279 EASTBOUND PRO-07	SHEET 83 OF 468