


NOTE:  
 ELEVATIONS SHOWN TO THE NEAREST HUNDREDTH ARE EXISTING GROUND.  
 ELEVATIONS SHOWN TO THE NEAREST THOUSANDTH ARE FINISH GRADE.

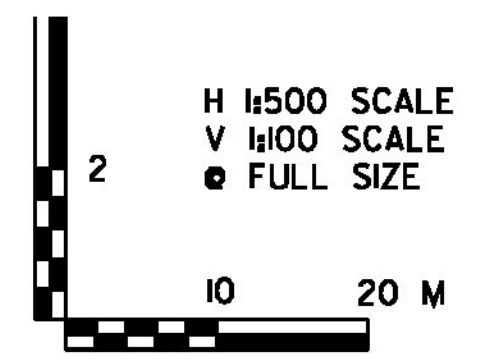

PROJECT NAME:	BENNINGTON
PROJECT NUMBER:	NH 019-1(54)
FILE NAME:	..\\zd307c4pro.279EB.pjf
DESIGN SUPERVISOR:	GREG EDWARDS
DESIGNED BY:	MARC FOISY
VT ROUTE 279 EASTBOUND PRO-08	
PLOT DATE:	1/26/2010
DRAWN BY:	STANTEC
CHECKED BY:	GARY SANTY
SHEET	84 OF 468

1/26/2010 4:47:14 PM v:\953\active\953002\transportation\drawing\contract\4\plot\_files\z307c4pro.279EB.pjf