


NOTE:  
ELEVATIONS SHOWN TO THE NEAREST HUNDREDTH ARE EXISTING GROUND.  
ELEVATIONS SHOWN TO THE NEAREST THOUSANDTH ARE FINISH GRADE.

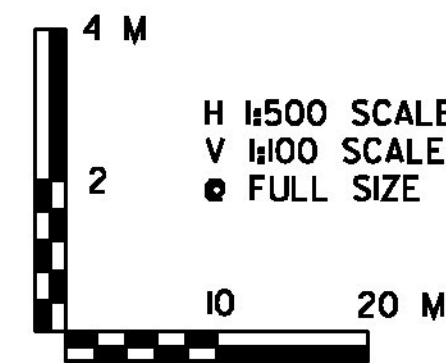

PROJECT NAME: BENNINGTON  
PROJECT NUMBER: NH 019-1(54)

FILE NAME: ..\zd307c4pro.279EB.prf  
DESIGN SUPERVISOR: GREG EDWARDS  
DESIGNED BY: MARC FOISY  
VT ROUTE 279 EASTBOUND PRO-10

PLOT DATE: 1/26/2010  
DRAWN BY: STANTEC  
CHECKED BY: GARY SANTY  
SHEET 86 OF 468