


+0.080
 +0.060
 +0.040
 +0.020
 LEVEL
 -0.020
 -0.040
 -0.060
 -0.080

e = MATCH EXISTING

+0.080
 +0.060
 +0.040
 +0.020
 LEVEL
 -0.020
 -0.040
 -0.060
 -0.080

NOTE:
 ELEVATIONS SHOWN TO THE NEAREST HUNDREDTH ARE EXISTING GROUND.
 ELEVATIONS SHOWN TO THE NEAREST THOUSANDTH ARE FINISH GRADE.

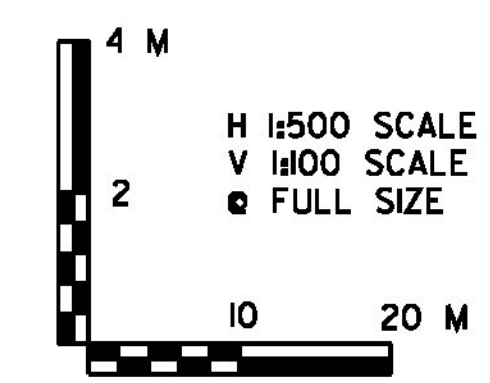

PROJECT NAME:	BENNINGTON	PLOT DATE:	1/26/2010
PROJECT NUMBER:	NH 019-1(54)	DRAWN BY:	STANTEC
FILE NAME:	..\\zd307c4pro.Ramp.G.ptf	CHECKED BY:	GARY SANTY
DESIGN SUPERVISOR:	GREG EDWARDS	SHEET	91 OF 468
DESIGNED BY:	MARC FOISY		
RAMP G PRO-15			

1/26/2010 4:47:23 PM v:\953\active\953002\transportation\contract\4\pilot_files\z307c4pro.Ramp.G.ptf