


NOTE:
 ELEVATIONS SHOWN TO THE NEAREST HUNDREDTH ARE EXISTING GROUND.
 ELEVATIONS SHOWN TO THE NEAREST THOUSANDTH ARE FINISH GRADE.

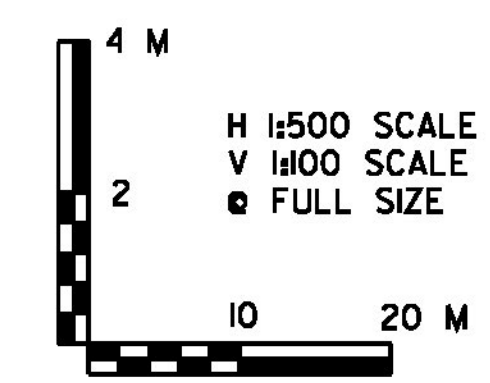

PROJECT NAME:	BENNINGTON	PLOT DATE:	1/26/2010
PROJECT NUMBER:	NH 019-1(54)	DRAWN BY:	STANTEC
FILE NAME:	..\\zd307c4pro.Ramp.G.p1f	CHECKED BY:	GARY SANTY
DESIGN SUPERVISOR:	GREG EDWARDS	SHEET	93 OF 468
DESIGNED BY:	MARC FOISY		
RAMP G PRO-17			

1/26/2010 4:47:25 PM v:\953\active\9530092\transportation\drw\m\9530092\pro.Ramp.G.p1f