


+0.080
 +0.060
 +0.040
 +0.020
 LEVEL
 -0.020
 -0.040
 -0.060
 -0.080

CONST C (PGL)

e = 0.020

+0.080
 +0.060
 +0.040
 +0.020
 LEVEL
 -0.020
 -0.040
 -0.060
 -0.080

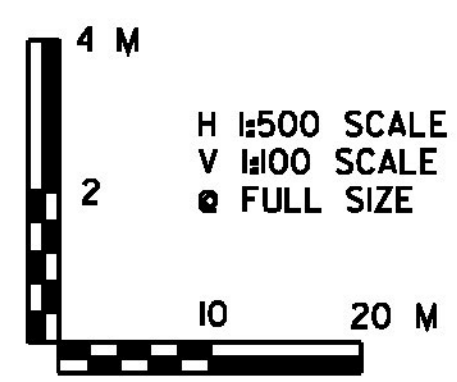

NOTE:
 ELEVATIONS SHOWN TO THE NEAREST HUNDRETH ARE EXISTING GROUND.
 ELEVATIONS SHOWN TO THE NEAREST THOUSANDTH ARE FINISH GRADE.



PROJECT NAME:	BENNINGTON
PROJECT NUMBER:	NH 019-1(54)
FILE NAME:	..\\zd307c4pro.Ramp.lptf
DESIGN SUPERVISOR:	GREG EDWARDS
DESIGNED BY:	MARC FOISY
RAMP 1 PRO-18	
PLOT DATE:	1/26/2010
DRAWN BY:	STANTEC
CHECKED BY:	GARY SANTY
SHEET	94 OF 468

1/26/2010 4:47:27 PM v:\953\active\953002\transportation\drawing\contract\4\pilot_files\zd307c4pro.Ramp.lptf