


NOTE:  
 ELEVATIONS SHOWN TO THE NEAREST HUNDREDTH ARE EXISTING GROUND.  
 ELEVATIONS SHOWN TO THE NEAREST THOUSANDTH ARE FINISH GRADE.

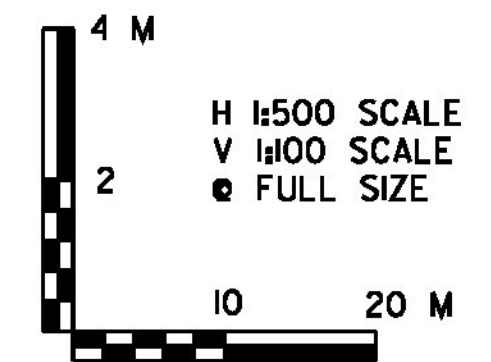

PROJECT NAME:	BENNINGTON	PLOT DATE:	1/26/2010
PROJECT NUMBER:	NH 019-1(54)	DRAWN BY:	STANTEC
FILE NAME:	...z307c4pro.Ramp.1.2.dgn	CHECKED BY:	GARY SANTY
DESIGN SUPERVISOR:	GREG EDWARDS	SHEET	95 OF 468
DESIGNED BY:	MARC FOISY		
<b>RAMP 1 PRO-19</b>			

1/26/2010 4:47:28 PM V:\953\active\953002\transportation\drawings\contract\4\pilot\_files\z307c4pro.Ramp.1.2.dgn