


+0.080  
 +0.060  
 +0.040  
 +0.020  
 LEVEL  
 -0.020  
 -0.040  
 -0.060  
 -0.080

+0.080  
 +0.060  
 +0.040  
 +0.020  
 LEVEL  
 -0.020  
 -0.040  
 -0.060  
 -0.080



NOTE:  
 ELEVATIONS SHOWN TO THE NEAREST HUNDRETH ARE EXISTING GROUND.  
 ELEVATIONS SHOWN TO THE NEAREST THOUSANDTH ARE FINISH GRADE.

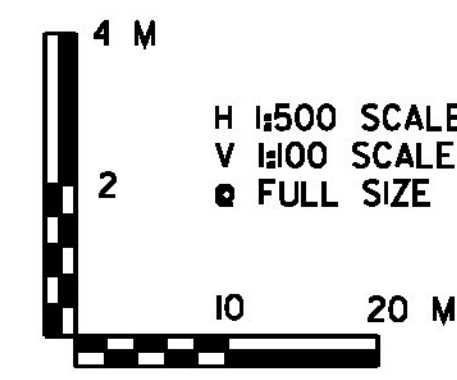

PROJECT NAME:	BENNINGTON
PROJECT NUMBER:	NH 019-1(54)
FILE NAME:	..\\zd307c4pro.Ramp.L.ptf
DESIGN SUPERVISOR:	GREG EDWARDS
DESIGNED BY:	MARC FOISY
RAMP L PRO-20	
PLOT DATE:	1/26/2010
DRAWN BY:	STANTEC
CHECKED BY:	GARY SANTY
SHEET	96 OF 468

I:\26\2010\_4473\1P\ v:\953\active\953002\transportation\rdw\m\contract\4\blot\_files\z307c4pro.Ramp.L.ptf