


* SECTIONS SHOWN IN RAMP F CROSS SECTIONS.

SEE REVISED SHEET

NOTE:
 ELEVATIONS SHOWN TO THE NEAREST HUNDREDTH ARE EXISTING GROUND.
 ELEVATIONS SHOWN TO THE NEAREST THOUSANDTH ARE FINISH GRADE.

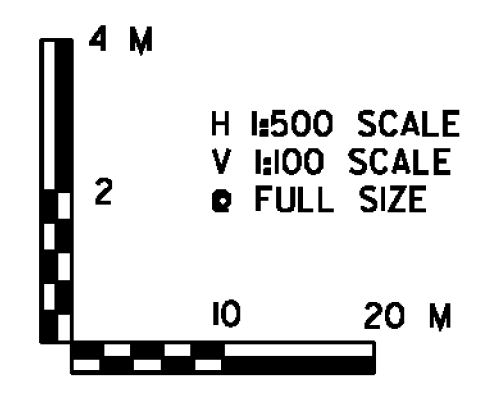

PROJECT NAME: BENNINGTON	PLOT DATE: 1/26/2010
PROJECT NUMBER: NH 019-(154)	DRAWN BY: STANTEC
FILE NAME: ...zd307c4pro.Ramp.Nptf	CHECKED BY: GARY SANTY
DESIGN SUPERVISOR: GREG EDWARDS	SHEET 98 OF 468
DESIGNED BY: MARC FOISY	
RAMP N PRO-22	

1/26/2010 4:47:33 PM v:\1953\active\1953\002\transportation\drawing\conform\4\plot_files\z307c4pro.Ramp.Nptf