


LEVEL  
+0.080  
+0.060  
+0.040  
+0.020  
-0.020  
-0.040  
-0.060  
-0.080

*Record Plans*

\* SECTIONS SHOWN IN RAMP F CROSS SECTIONS.

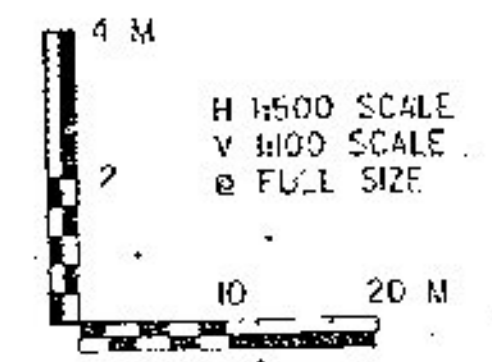

	PROJECT NAME: BENNINGTON
	PROJECT NUMBER: NH 019-1(54)
FILE NAME: ...\zd307c\pro_Ramp_N.ppt	PLOT DATE: 5/27/2010
DESIGN SUPERVISOR: GREG EDWARDS	DRAWN BY: STANTEC
DESIGNED BY: MARC FOISY	CHECKED BY: GARY SARTY
RAMP N PRO-22	SHEET 2F

HUNDRETH ARE EXISTING GROUND.  
THOUSANDTH ARE FINISH GRADE.