


NOTE:
ELEVATIONS SHOWN TO THE NEAREST HUNDREDTH ARE EXISTING GROUND.
ELEVATIONS SHOWN TO THE NEAREST THOUSANDTH ARE FINISH GRADE.

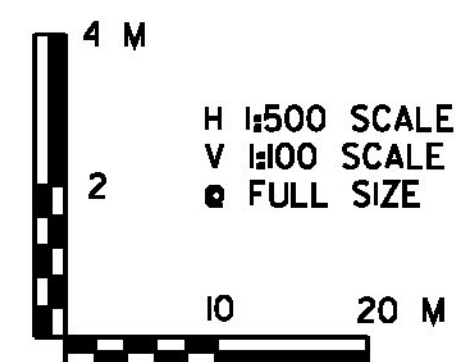

PROJECT NAME: BENNINGTON
PROJECT NUMBER: NH 019-1(54)

FILE NAME: ..\zd307c4pro.Romp.P.tif
DESIGN SUPERVISOR: GREG EDWARDS
DESIGNED BY: MARC FOISY
RAMP P PRO-23

PLOT DATE: 3/16/2010
DRAWN BY: STANTEC
CHECKED BY: GARY SANTY
SHEET 99 OF 468

3/16/2010 10:27:11 AM v:\953\active\953002\transportation\drw\m\com\trac\4\plot\files\zd307c4pro.Romp.P.tif