



**STA. Q 1+000.000**  
**END COLD PLANE/OVERLAY**  
**BEGIN FULL DEPTH CONSTRUCTION**

POT STA. Q 1+000.000 =  
 PC STA. G. 1+404.030  
 ELEV. = 193.682

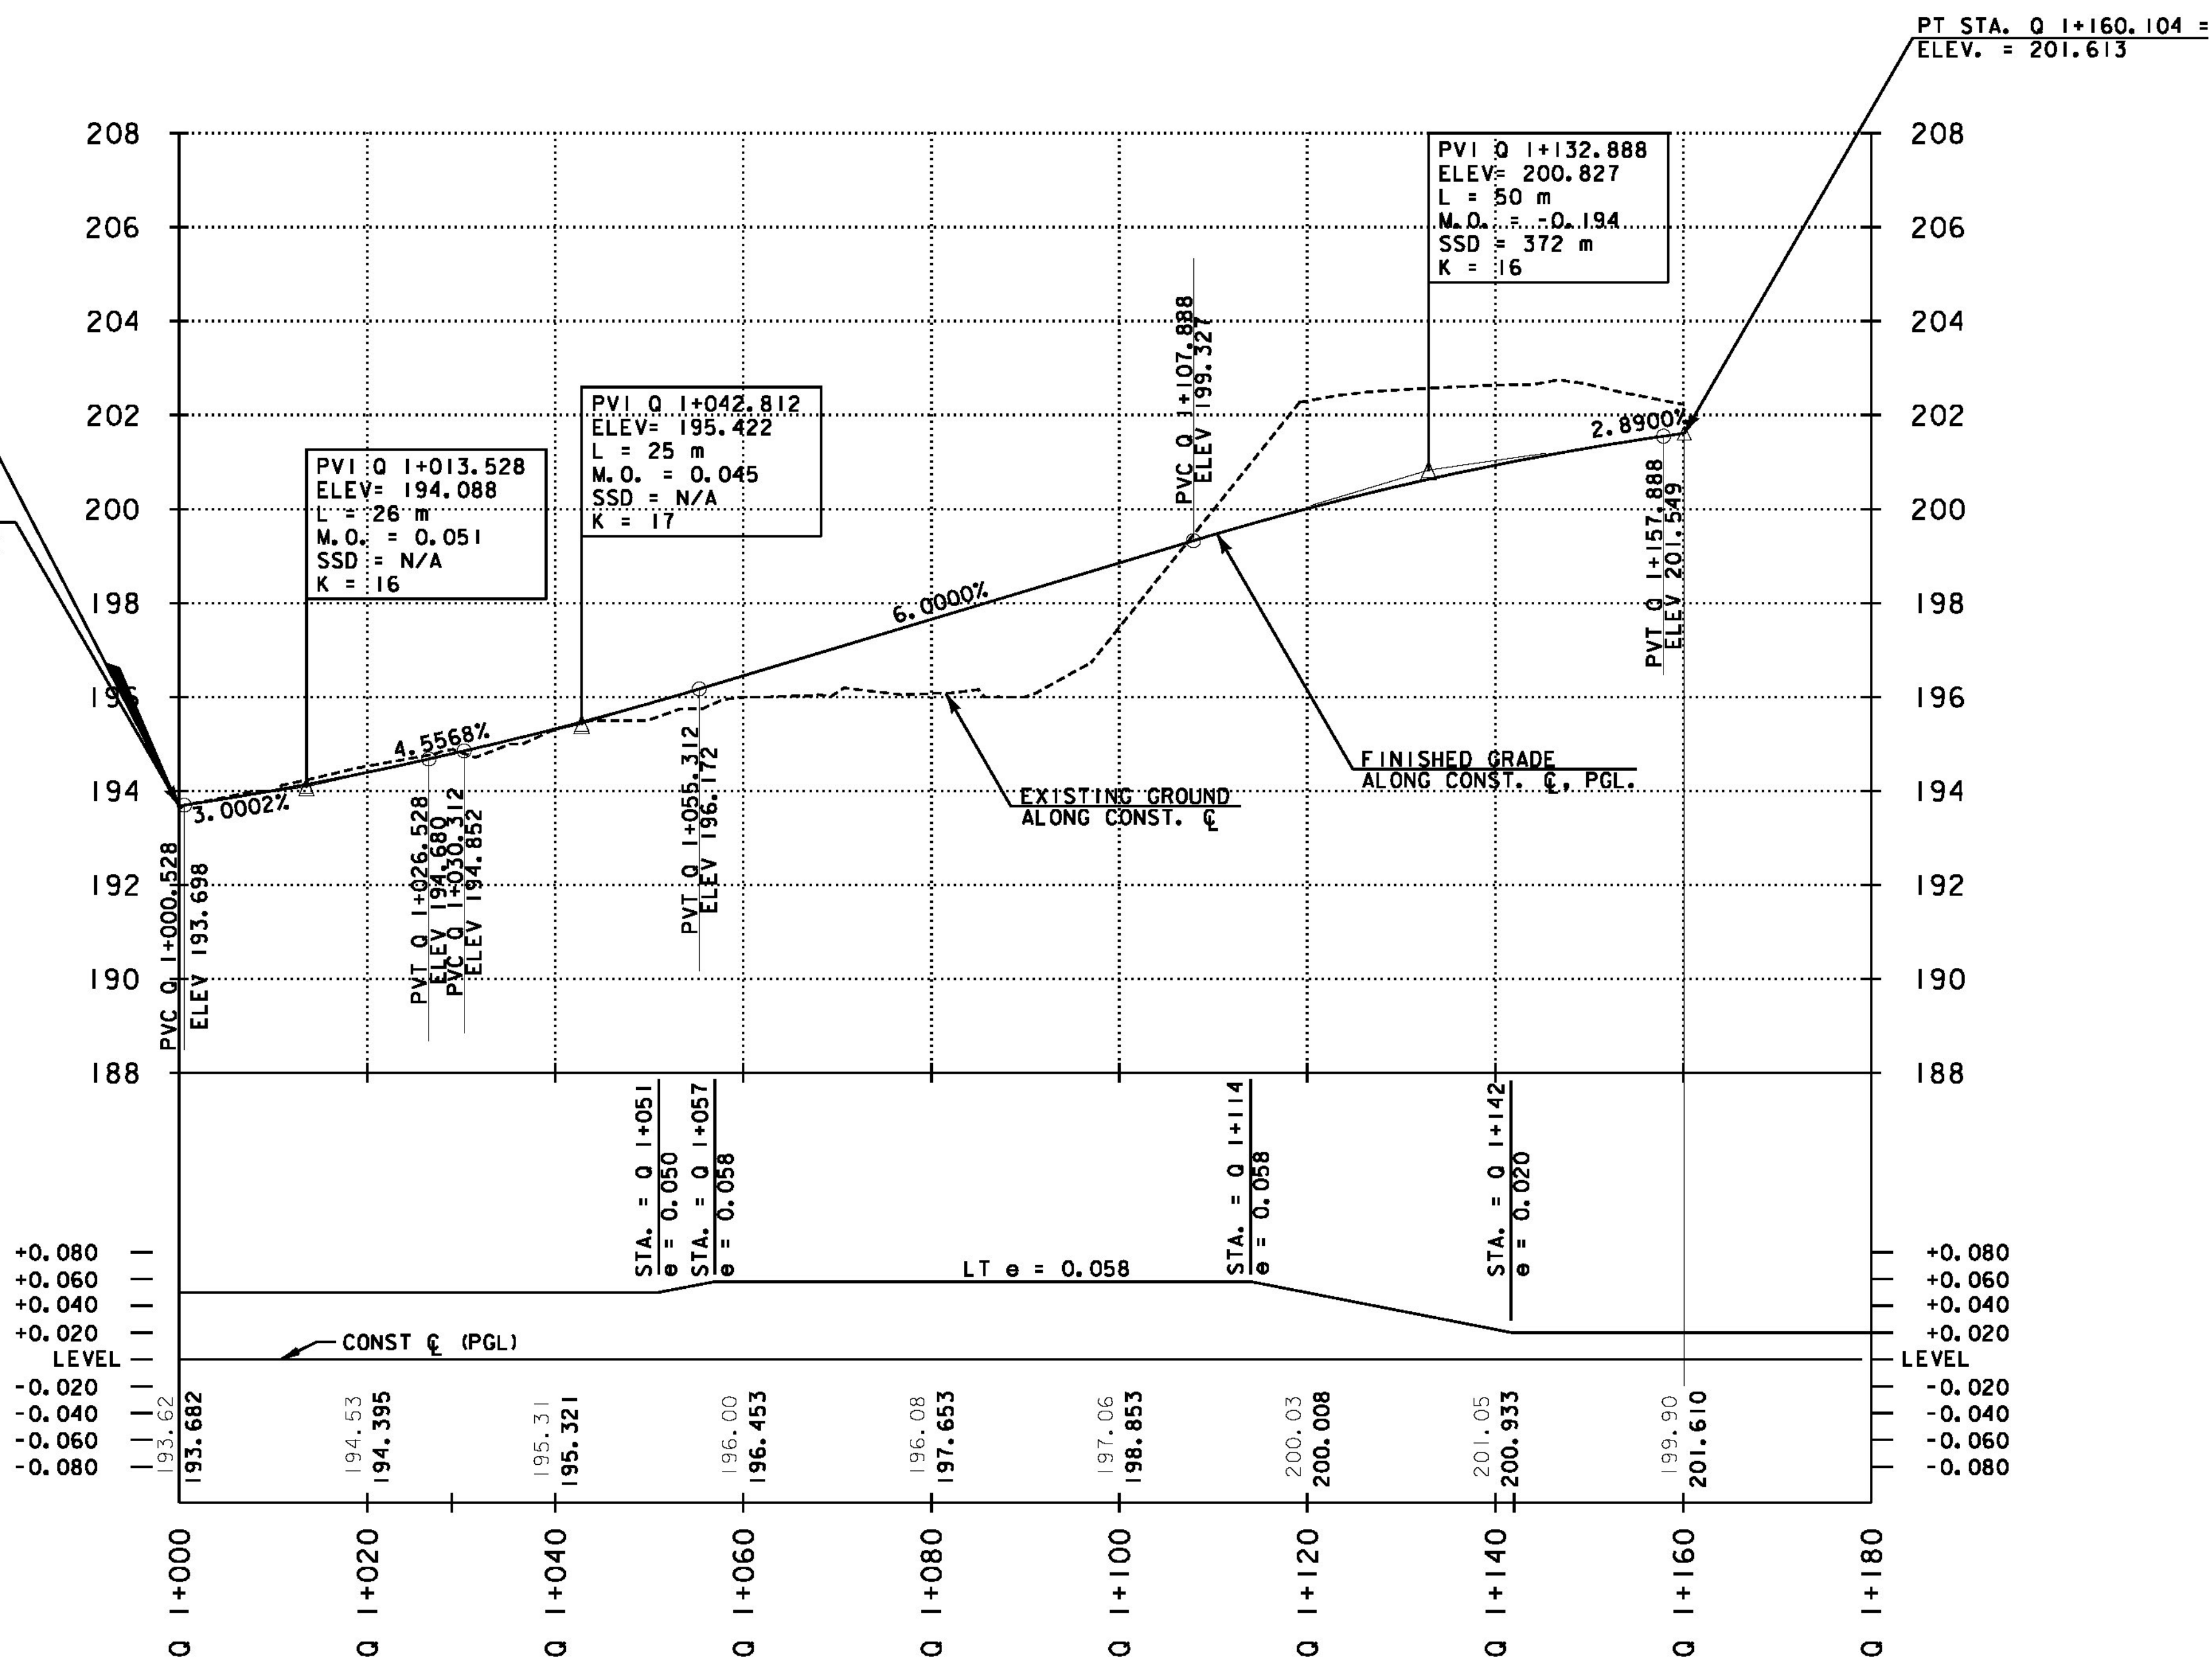

NOTE:  
 ELEVATIONS SHOWN TO THE NEAREST HUNDREDTH ARE EXISTING GROUND.  
 ELEVATIONS SHOWN TO THE NEAREST THOUSANDTH ARE FINISH GRADE.

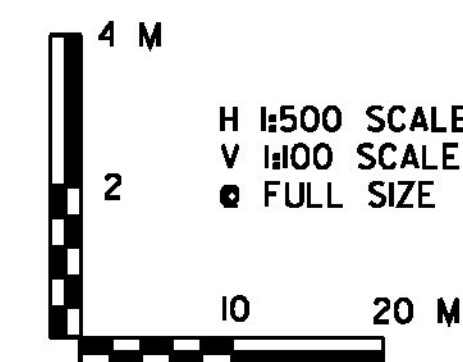

PROJECT NAME: BENNINGTON  
 PROJECT NUMBER: NH 019-1(54)  
 FILE NAME: ..\zd307c4pro.Ramp.0.pxf  
 DESIGN SUPERVISOR: GREG EDWARDS  
 DESIGNED BY: MARC FOISY  
 RAMP Q PRO-24

PLOT DATE: 1/26/2010  
 DRAWN BY: STANTEC  
 CHECKED BY: GARY SANTY  
 SHEET 100 OF 468