


1/26/2010 4:47:38 PM v:\1953\active\19530002\transportation\drawings\contract\4\p19\files\26107\4\pro_Ramp_R.prf

NOTE:
 ELEVATIONS SHOWN TO THE NEAREST HUNDREDTH ARE EXISTING GROUND.
 ELEVATIONS SHOWN TO THE NEAREST THOUSANDTH ARE FINISH GRADE.

* SECTIONS SHOWN IN RAMP G CROSS SECTIONS.
 GXS-01-GXS-12

SEE REVISED SHEET

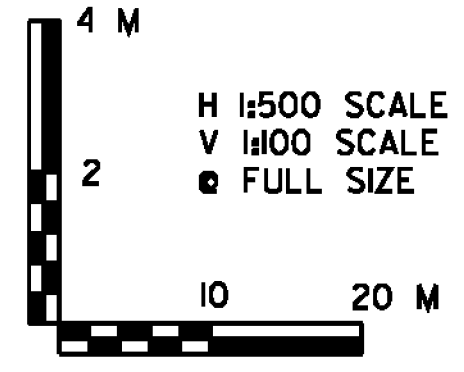

PROJECT NAME: BENNINGTON	PLOT DATE: 1/26/2010
PROJECT NUMBER: NH 019-(154)	DRAWN BY: STANTEC
FILE NAME: ...zd307c4pro_Ramp.R.ptf	CHECKED BY: GARY SANTY
DESIGN SUPERVISOR: GREG EDWARDS	SHEET 101 OF 468
DESIGNED BY: MARC FOISY	
RAMP R PRO-25	