


LEVEL	+0.080	—	+	0.080
	+0.060	—	+	0.060
	+0.040	—	+	0.040
	+0.020	—	+	0.020
LEVEL	-0.020	—	-	0.020
	-0.040	—	-	0.040
	-0.060	—	-	0.060
	-0.080	—	-	0.080

\* SECTIONS SHOWN IN RAMP F CROSS SECTIONS.  
FXS-01-FXS-15



NOTE:  
ELEVATIONS SHOWN TO THE NEAREST HUNDREDTH ARE EXISTING GROUND.  
ELEVATIONS SHOWN TO THE NEAREST THOUSANDTH ARE FINISH GRADE.

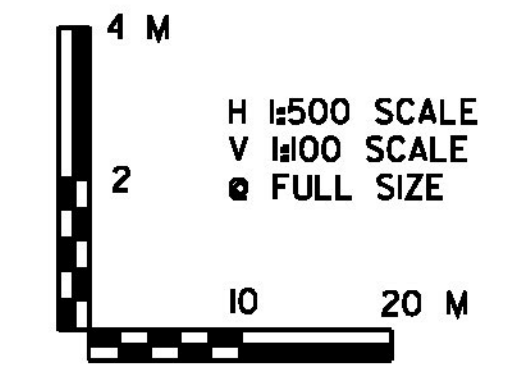

PROJECT NAME:	BENNINGTON
PROJECT NUMBER:	NH 019-1(54)
FILE NAME:	..\\zd307c4pro.Ramp.T.plt
DESIGN SUPERVISOR:	GREG EDWARDS
DESIGNED BY:	MARC FOISY
RAMP T PRO-27	
PLOT DATE:	1/26/2010
DRAWN BY:	STANTEC
CHECKED BY:	GARY SANTY
SHEET	103 OF 468

I:\26\2010\_44742\_Plan\1953\active\1953002\transportation\drawing\contract\4\plot\_files\z307c4pro.Ramp.T.plt