


NOTE:  
 ELEVATIONS SHOWN TO THE NEAREST HUNDREDTH ARE EXISTING GROUND.  
 ELEVATIONS SHOWN TO THE NEAREST THOUSANDTH ARE FINISH GRADE.

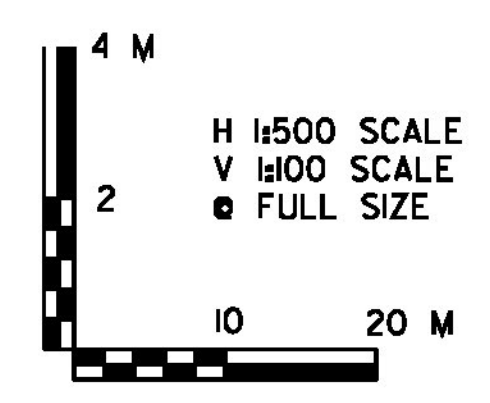

PROJECT NAME:	BENNINGTON
PROJECT NUMBER:	NH 019-1(54)
FILE NAME:	..\\zd307c4pro.Romp.U.plt
DESIGN SUPERVISOR:	GREG EDWARDS
DESIGNED BY:	MARC FOISY
RAMP U PRO-28	
PLOT DATE:	1/26/2010
DRAWN BY:	STANTEC
CHECKED BY:	GARY SANTY
SHEET	104 OF 468

1/26/2010 4:47:44 PM V:\953\active\953002\transportation\drawing\contract\4\blot\_files\zd307c4pro.Romp.U.plt