


LEVEL
+0.080
+0.060
+0.040
+0.020
-0.020
-0.040
-0.060
-0.080

LEVEL
+0.080
+0.060
+0.040
+0.020
-0.020
-0.040
-0.060
-0.080

NOTE:
ELEVATIONS SHOWN TO THE NEAREST HUNDREDTH ARE EXISTING GROUND.
ELEVATIONS SHOWN TO THE NEAREST THOUSANDTH ARE FINISH GRADE.

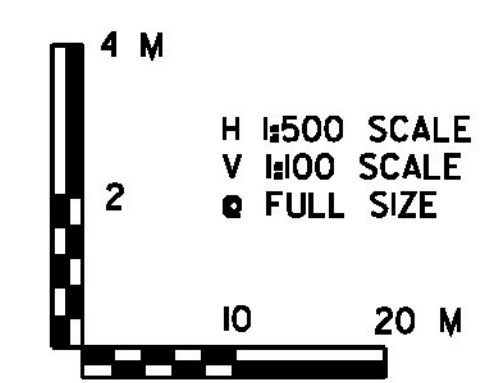

PROJECT NAME:	BENNINGTON
PROJECT NUMBER:	NH 019-1(54)
FILE NAME:	...z307c4pro.7NB.BK.ptf
DESIGN SUPERVISOR:	GREG EDWARDS
DESIGNED BY:	MARC FOISY
US ROUTE 7 NORTHBOUND	PRO-30
PLOT DATE:	1/26/2010
DRAWN BY:	STANTEC
CHECKED BY:	GARY SANTY
SHEET	106 OF 468

1/26/2010 4:47:47 PM v:\953\active\953002\transportation\drawing\contract\4\blot_files\z307c4pro.7NB.BK.ptf