


NOTE:
ELEVATIONS SHOWN TO THE NEAREST HUNDRETH ARE EXISTING GROUND.
ELEVATIONS SHOWN TO THE NEAREST THOUSANDTH ARE FINISH GRADE.

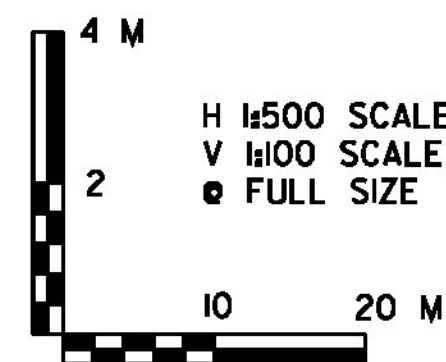

PROJECT NAME: BENNINGTON
PROJECT NUMBER: NH 019-1(54)
FILE NAME: ..\zd307c4pro.7NB.AH.plt
DESIGN SUPERVISOR: GREG EDWARDS
DESIGNED BY: MARC FOISY
ROUTE 7 NORTHBOUND PRO-32

PLOT DATE: 1/26/2010
DRAWN BY: STANTEC
CHECKED BY: GARY SANTY
SHEET 108 OF 468