



FOR PROFILE BETWEEN STA. SB 10+212.607 AND STA. SB 10+567.592 SEE VT 279 EB PROFILE SHEETS PR-08 AND PR-09

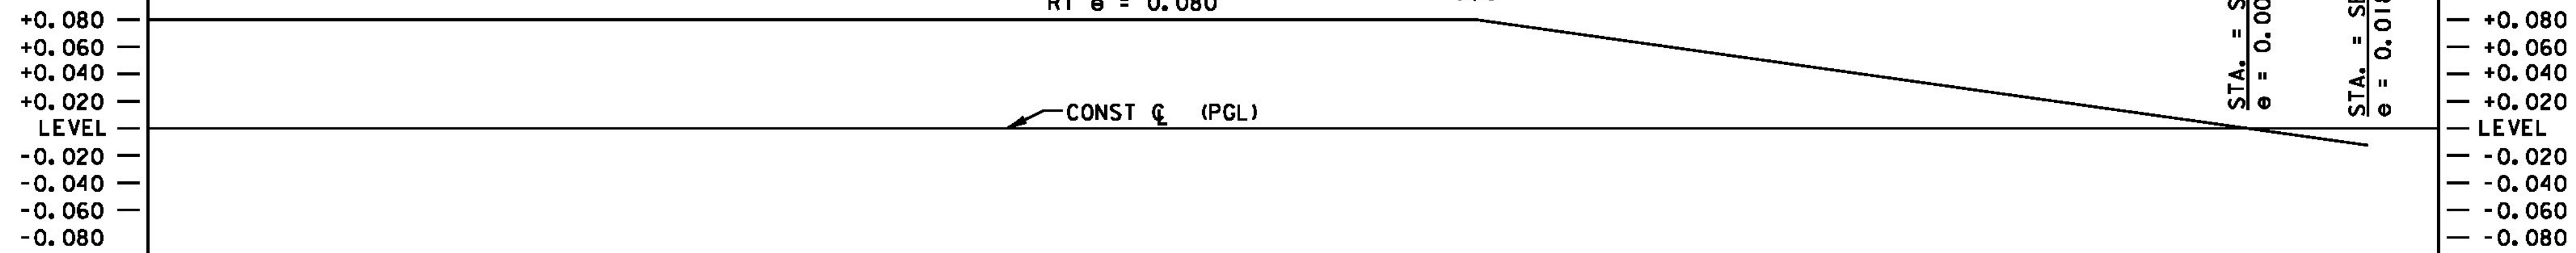

Level	Station	Elevation
+0.080		
+0.060		
+0.040		
+0.020		
LEVEL		
-0.020		
-0.040		
-0.060		
-0.080		

NOTE:
ELEVATIONS SHOWN TO THE NEAREST HUNDRETH ARE EXISTING GROUND.
ELEVATIONS SHOWN TO THE NEAREST THOUSANDTH ARE FINISH GRADE.

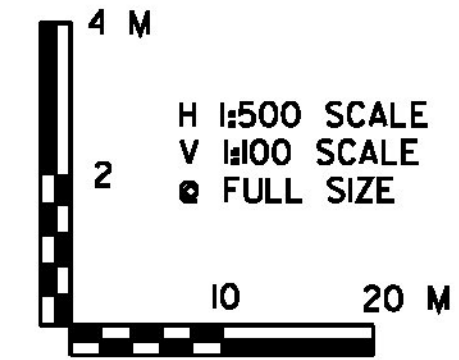

PROJECT NAME:	BENNINGTON
PROJECT NUMBER:	NH 019-1(54)
FILE NAME:	...z307c4pro.75B.BK.ptf
DESIGN SUPERVISOR:	GREG EDWARDS
DESIGNED BY:	MARC FOISY
US ROUTE 7 SOUTHBOUND PRO-36	
PLOT DATE:	1/26/2010
DRAWN BY:	STANTEC
CHECKED BY:	GARY SANTY
SHEET	112 OF 468

I:\26\2010_4\4\157 PM v\1953\active\1953002\transportation\drawing\contract\4\1953\files\z307c4pro.75B.BK.ptf