


LEVEL
 +0.080
 +0.060
 +0.040
 +0.020
 -0.020
 -0.040
 -0.060
 -0.080

LEVEL
 +0.080
 +0.060
 +0.040
 +0.020
 -0.020
 -0.040
 -0.060
 -0.080



NOTE:
 ELEVATIONS SHOWN TO THE NEAREST HUNDREDTH ARE EXISTING GROUND.
 ELEVATIONS SHOWN TO THE NEAREST THOUSANDTH ARE FINISH GRADE.

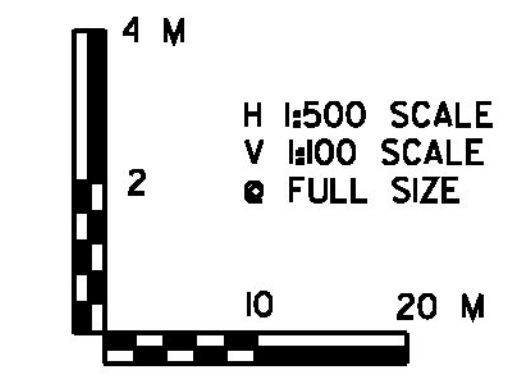

PROJECT NAME:	BENNINGTON	PLOT DATE:	1/26/2010
PROJECT NUMBER:	NH 019-1(54)	DRAWN BY:	STANTEC
FILE NAME:	...z307c4pro.7SB.BK.ptf	DESIGNED BY:	GARY SANTY
DESIGN SUPERVISOR:	GREG EDWARDS	CHECKED BY:	GARY SANTY
US ROUTE 7 SOUTHBOUND PRO-37		SHEET	113 OF 468

I:\26\2010_44755B_P\1\953\active\953002\transportation\drawing\sheet\4\plot_files\z307c4pro.7SB.BK.ptf