


LEVEL
+0.080
+0.060
+0.040
+0.020
-0.020
-0.040
-0.060
-0.080

LEVEL
+0.080
+0.060
+0.040
+0.020
-0.020
-0.040
-0.060
-0.080

NOTE:
ELEVATIONS SHOWN TO THE NEAREST HUNDRETH ARE EXISTING GROUND.
ELEVATIONS SHOWN TO THE NEAREST THOUSANDTH ARE FINISH GRADE.

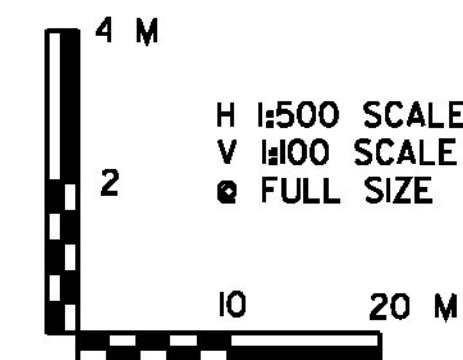

PROJECT NAME: BENNINGTON
PROJECT NUMBER: NH 019-1(54)
FILE NAME: ...zd307c4pro.7SB.BK.ptf
DESIGN SUPERVISOR: GREG EDWARDS
DESIGNED BY: MARC FOISY
US ROUTE 7 SOUTHBOUND PRO-38

PLOT DATE: 1/26/2010
DRAWN BY: STANTEC
CHECKED BY: GARY SANTY
SHEET 114 OF 468