


NOTE:
ELEVATIONS SHOWN TO THE NEAREST HUNDREDTH ARE EXISTING GROUND.
ELEVATIONS SHOWN TO THE NEAREST THOUSANDTH ARE FINISH GRADE.

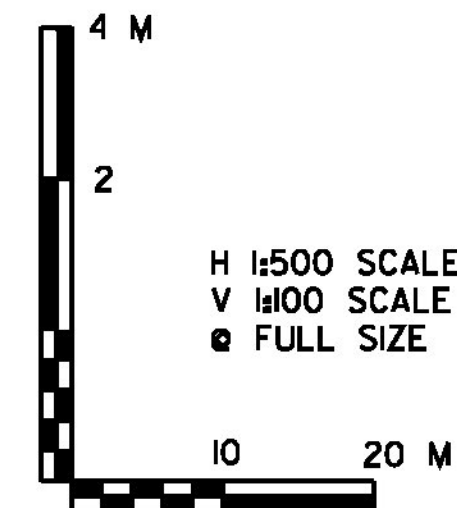

PROJECT NAME:	BENNINGTON	PLOT DATE:	1/26/2010
PROJECT NUMBER:	NH 019-1(54)	DRAWN BY:	STANTEC
FILE NAME:	...zd307c4pro.7SB.BK.ptf	CHECKED BY:	GARY SANTY
DESIGN SUPERVISOR:	GREG EDWARDS	SHEET	115 OF 468
DESIGNED BY:	MARC FOISY	US ROUTE 7 SOUTHBOUND PRO-39	

I:\26\2010 - 4\48\00 PM\11\53\active\11531002\transportation\drawing\const.ctb\4\plot_files\z307c4pro.7SB.BK.ptf