



REMOVING AND RESETTING FENCE
 STA. L 1+280.0, 9.7m LT. - L 1+300.0, 11.7m LT.

STEEL BEAM GUARDRAIL, GALVANIZED
 STA. F 1+103.5, 6.6m LT. - STA. F 1+110.0, 6.6m LT.

PROJECT DEMARCATION FENCE
 STA. L 1+280.0, RT. - STA. L 1+499.6, RT.
 STA. WB 9+637.8, RT. - STA. WB 9+880.0, RT.
 STA. EB 9+700.0, LT. - STA. EB 9+820.0, LT.



BITUMINOUS CONCRETE CURB, TYPE A
 STA. F 1+103.5, 6.6m LT. - STA. F 1+110.0, 6.6m LT.

MANUFACTURED TERMINAL SECTION, FLARED
 STA. F 1+092.1, 6.6m LT. - STA. F 1+103.5, 6.6m LT.

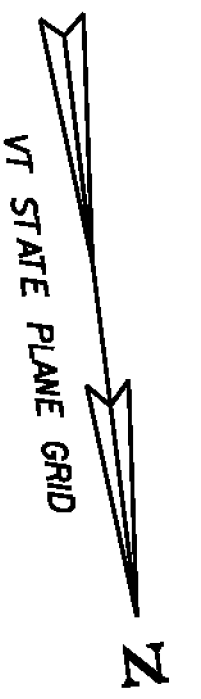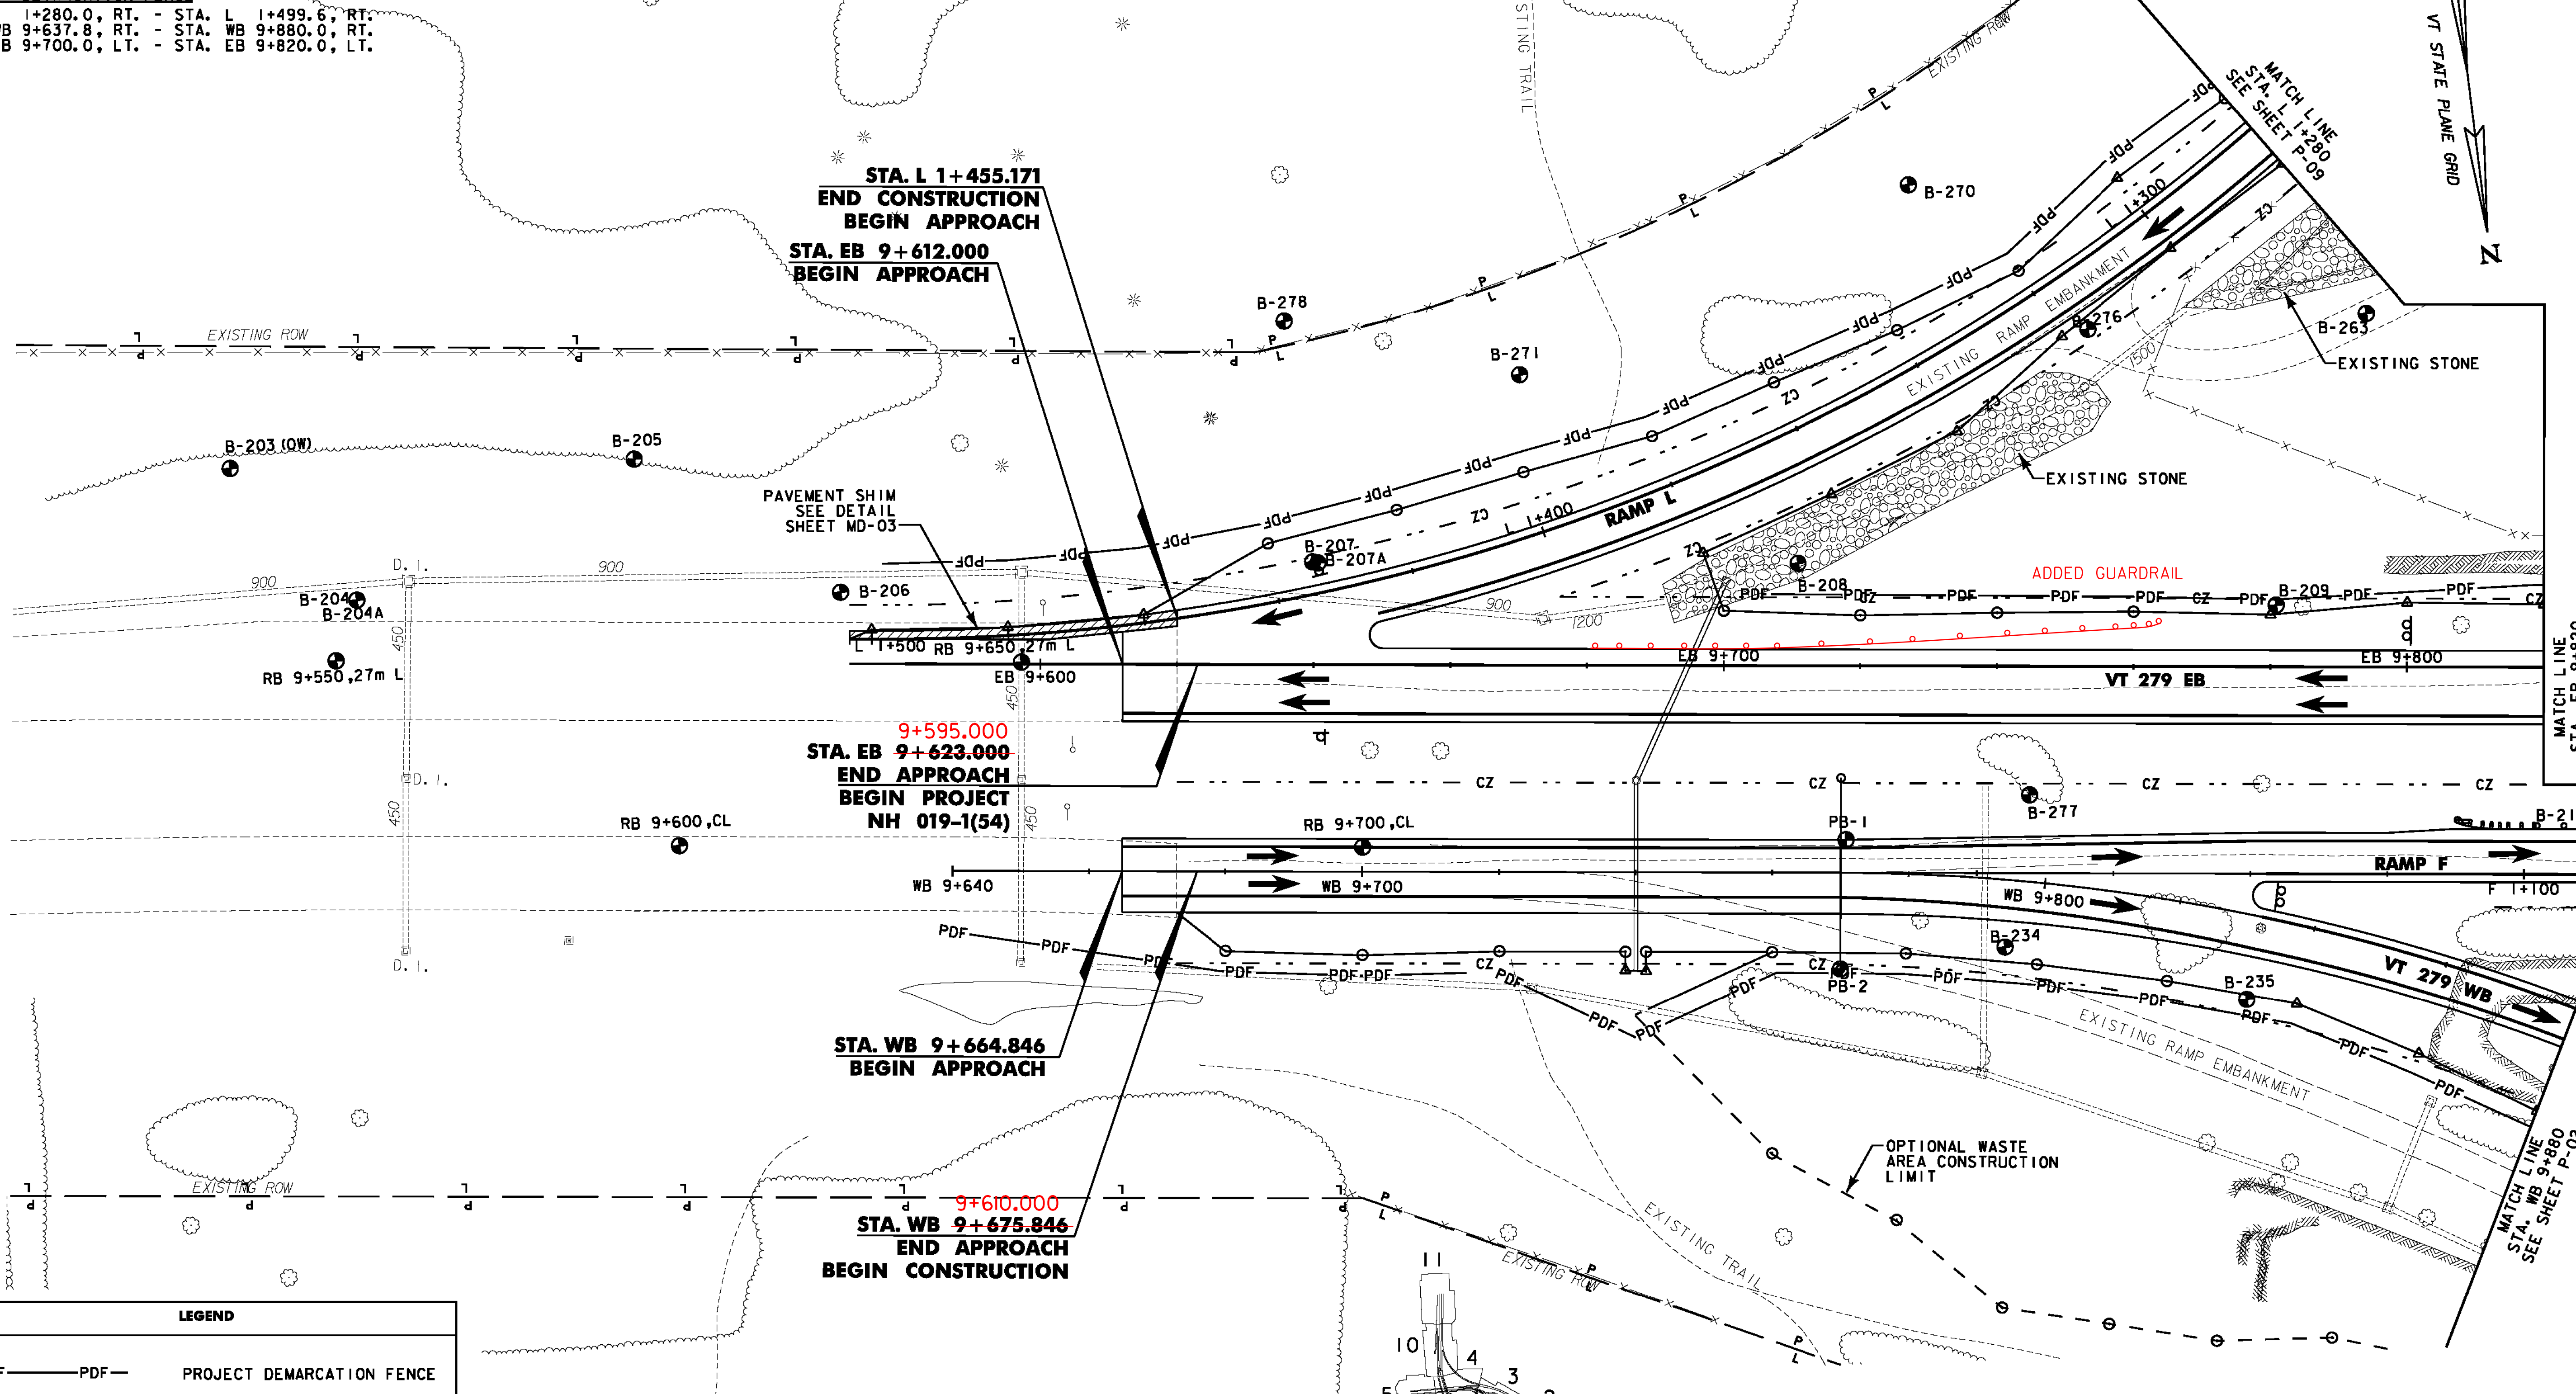

LEGEND

PDF — PDF	PROJECT DEMARCATION FENCE
— BF —	BARRIER FENCE
x — x — x	CHAIN-LINK FENCE
x — x — x	RIGHT OF WAY FENCE
— ARCH —	WETLAND BOUNDARY
— ARCH —	ARCHAEOLOGICAL SITE
—	WATER BOUNDARY
P — L	PROPERTY LINE

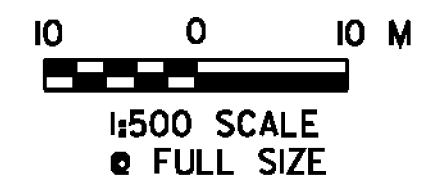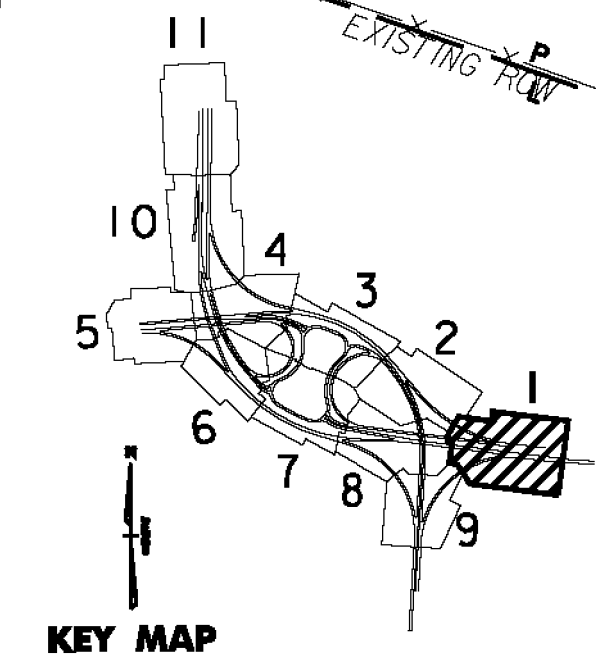

PROJECT NAME: BENNINGTON
 PROJECT NUMBER: NH 019-1(54)

FILE NAME: ...z307c4gen_plans.ptf
 DESIGN SUPERVISOR: GREG EDWARDS
 DESIGNED BY: MARC FOISY
 GENERAL PLAN P-01

PLOT DATE: 1/26/2010
 DRAWN BY: STANTEC
 CHECKED BY: GARY SANTY
 SHEET 116 OF 468

1/26/2010 4:48:04 PM v:\1953\getlive\1953\0002\tr\anspor\station\dr\awing\com\tr\cap_4\p101 - files\z307c4gen_plans.p11