



PROJECT DEMARCATION FENCE
 STA. WB 10+892.4, RT. - STA. WB 10+960.6, RT.
 STA. EB 10+780.0, LT. - STA. EB 10+973.1, LT.
 STA. EB 10+780.0, RT. - STA. EB 10+883.2, RT.

BARRIER FENCE
 STA. WB 10+890.0, RT. - STA. WB 10+943.1, RT.
 STA. WB 10+890.0, RT. - STA. I 1+604.4, LT.
 STA. EB 10+813.3, LT. - STA. G 1+180.0, RT.
 STA. G 1+157.6, RT. - STA. G 1+180.0, RT.

REMOVAL AND DISPOSAL OF GUARD RAIL
 STA. EB 10+922.0, 3.9m LT. - STA. EB 10+962.9, 6.0m LT.

STEEL BEAM GUARDRAIL, GALVANIZED
 STA. EB 10+921.1, 6.3m LT. - STA. EB 10+962.9, 6.0m LT.

ANCHOR FOR STEEL BEAM RAIL
 STA. EB 10+921.1, 6.3m LT.

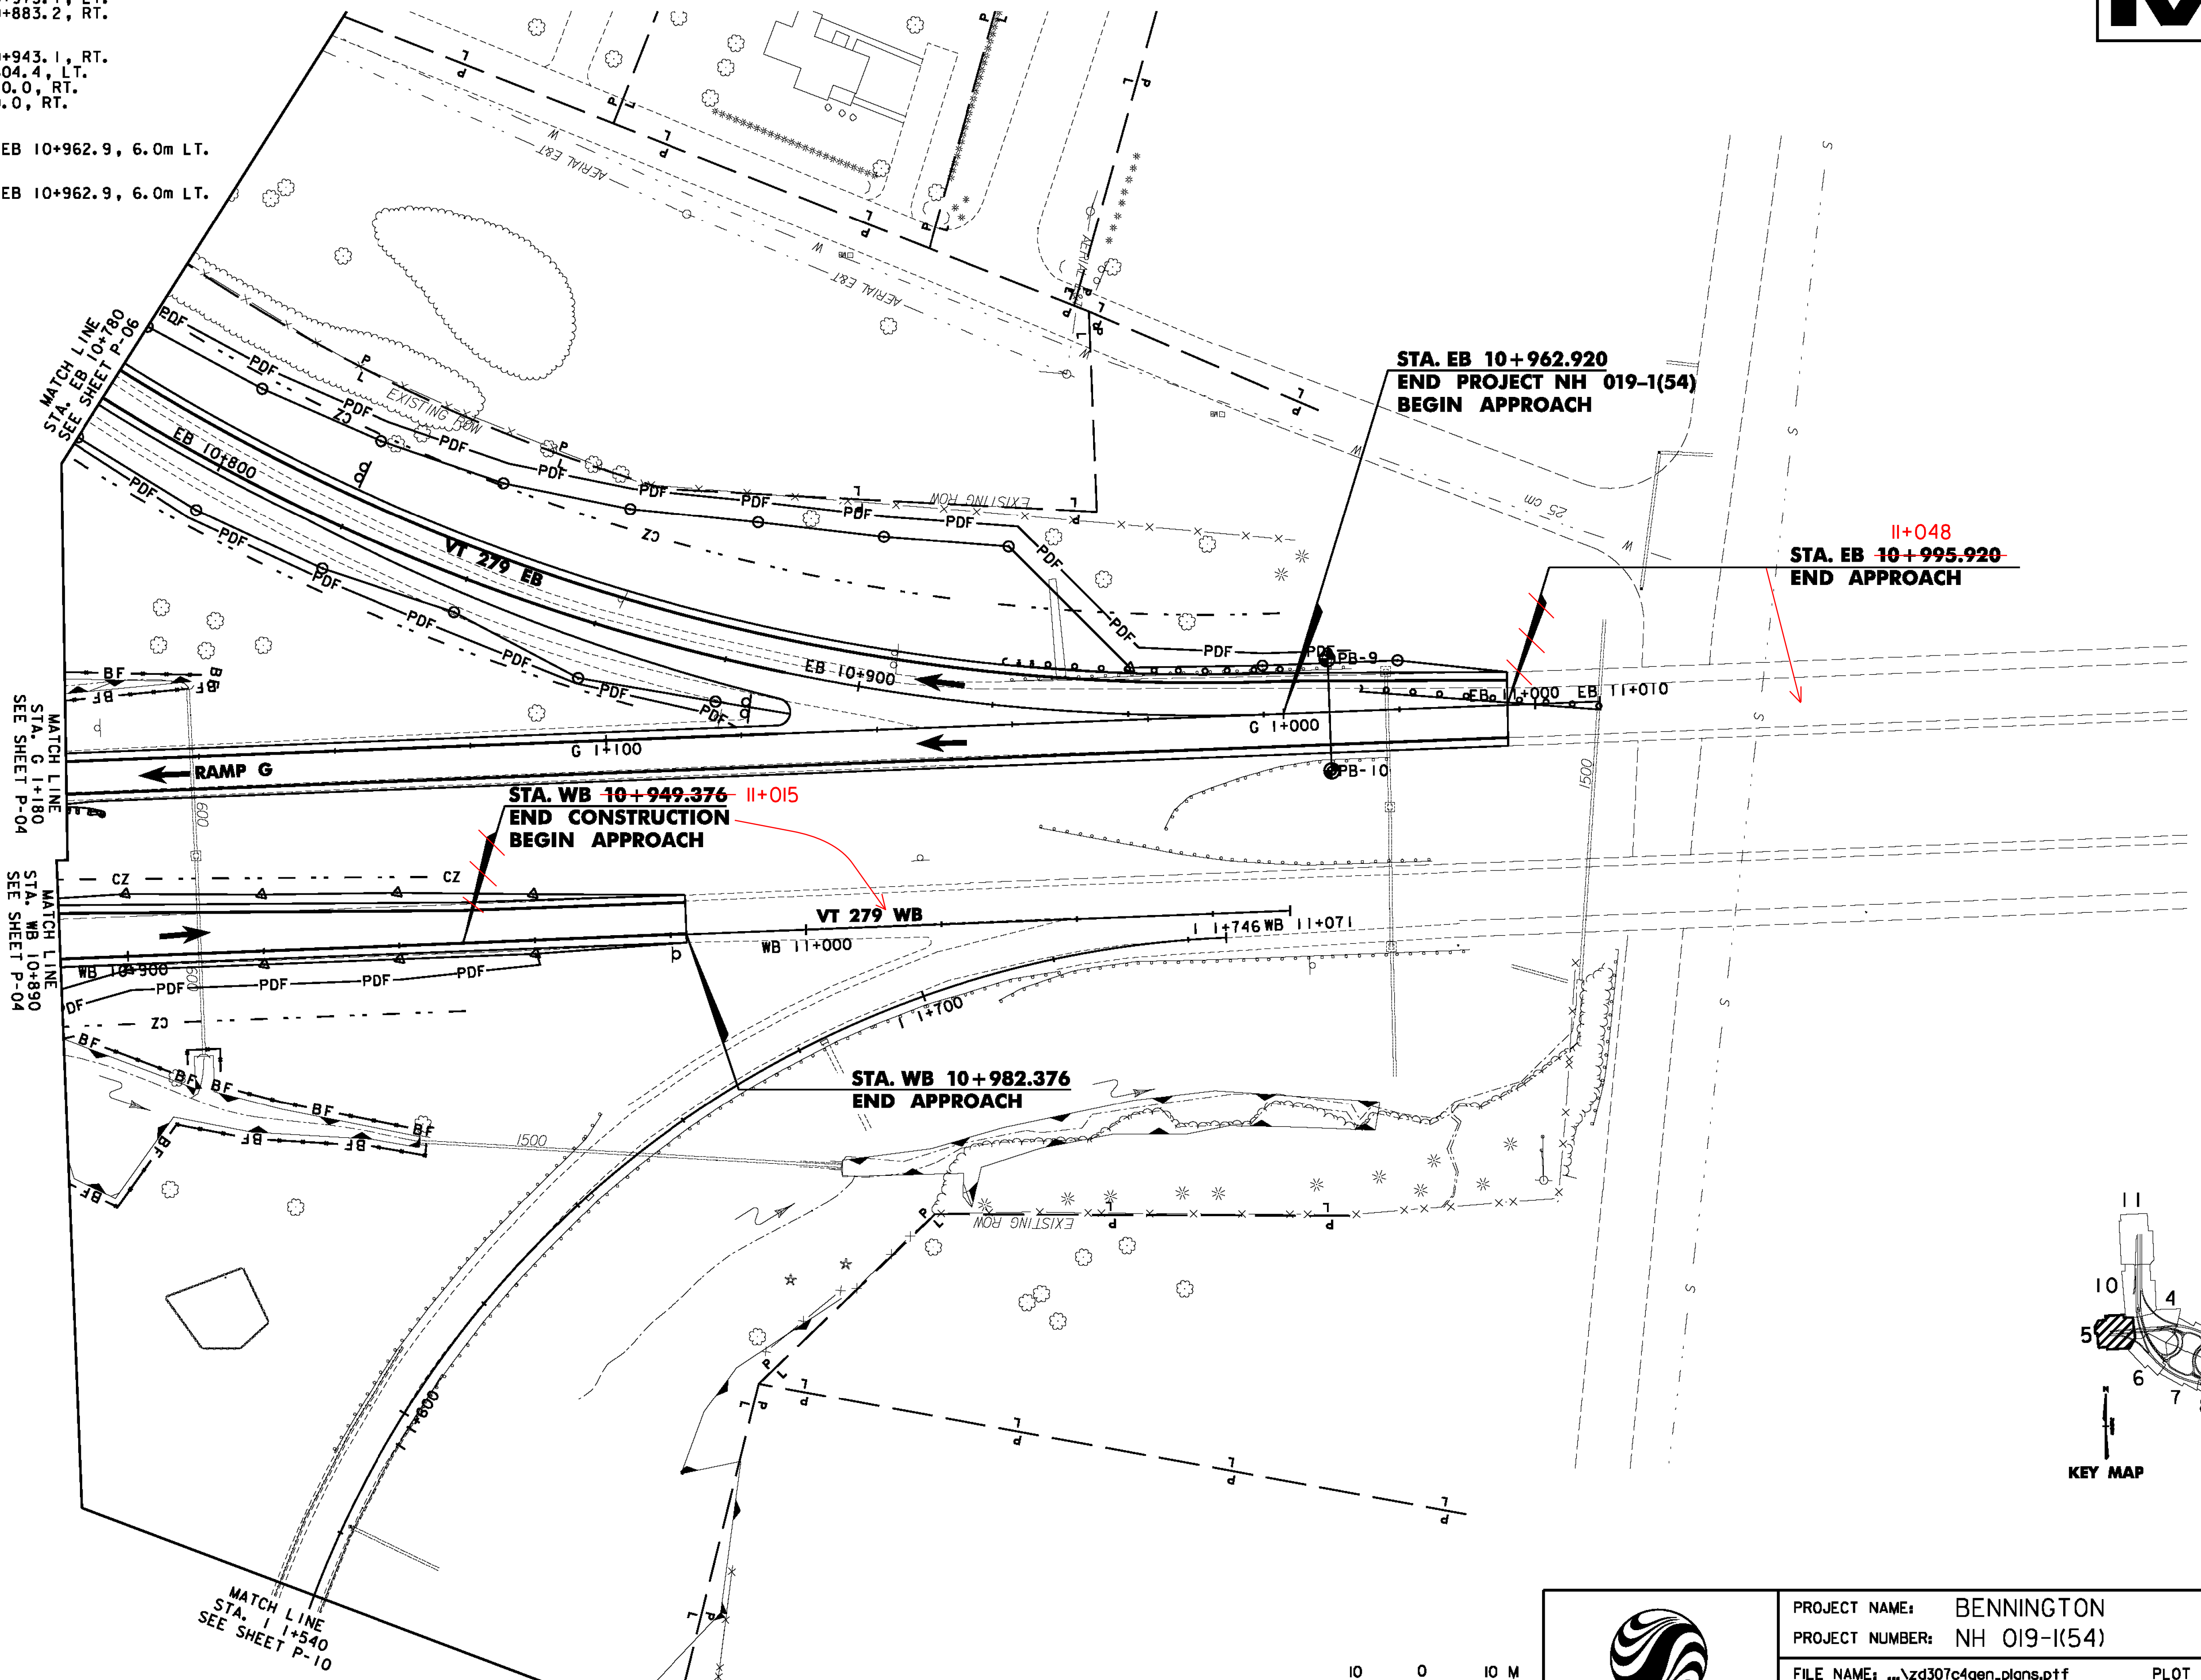
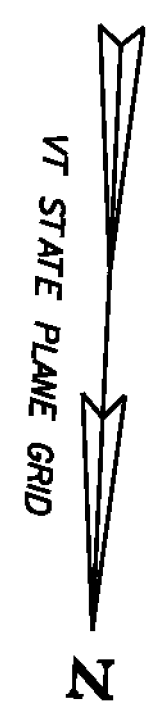


STA. EB 10+962.920
END PROJECT NH 019-1(54)
BEGIN APPROACH

II+048
STA. EB 10+995.920
END APPROACH

STA. WB 10+949.376 **II+015**
END CONSTRUCTION
BEGIN APPROACH

STA. WB 10+982.376
END APPROACH

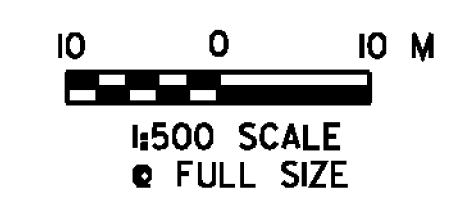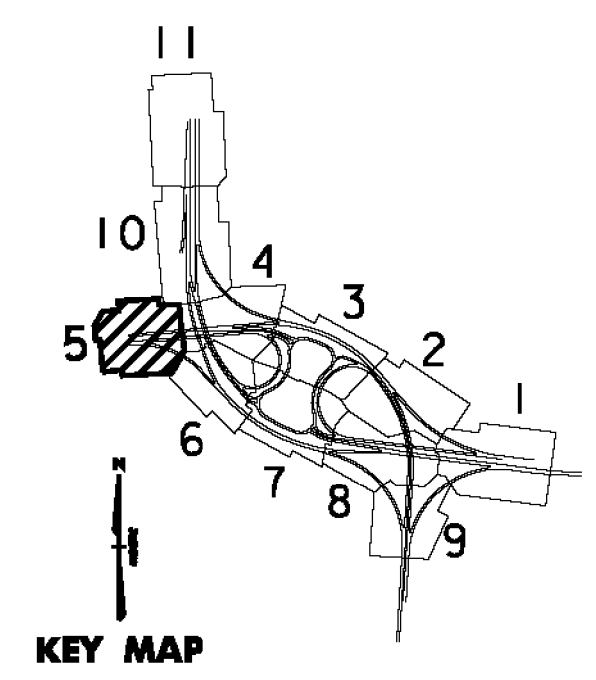

PROJECT NAME: BENNINGTON	PLOT DATE: 1/26/2010
PROJECT NUMBER: NH 019-1(54)	DRAWN BY: STANTEC
FILE NAME: ...zd307c4gen_plans.ptf	CHECKED BY: GARY SANTY
DESIGN SUPERVISOR: GREG EDWARDS	SHEET 120 OF 468
DESIGNED BY: MARC FOISY	
GENERAL PLAN P-05	

1/26/2010 4:48:13 PM v:\1953\del\va\1953\0002\tr\ansport\station\dr\aw\ng\com\tr\ast\4\p\ct\files\z6307c4gen_plans.ptf