




Utility Sleeve  
Revisions

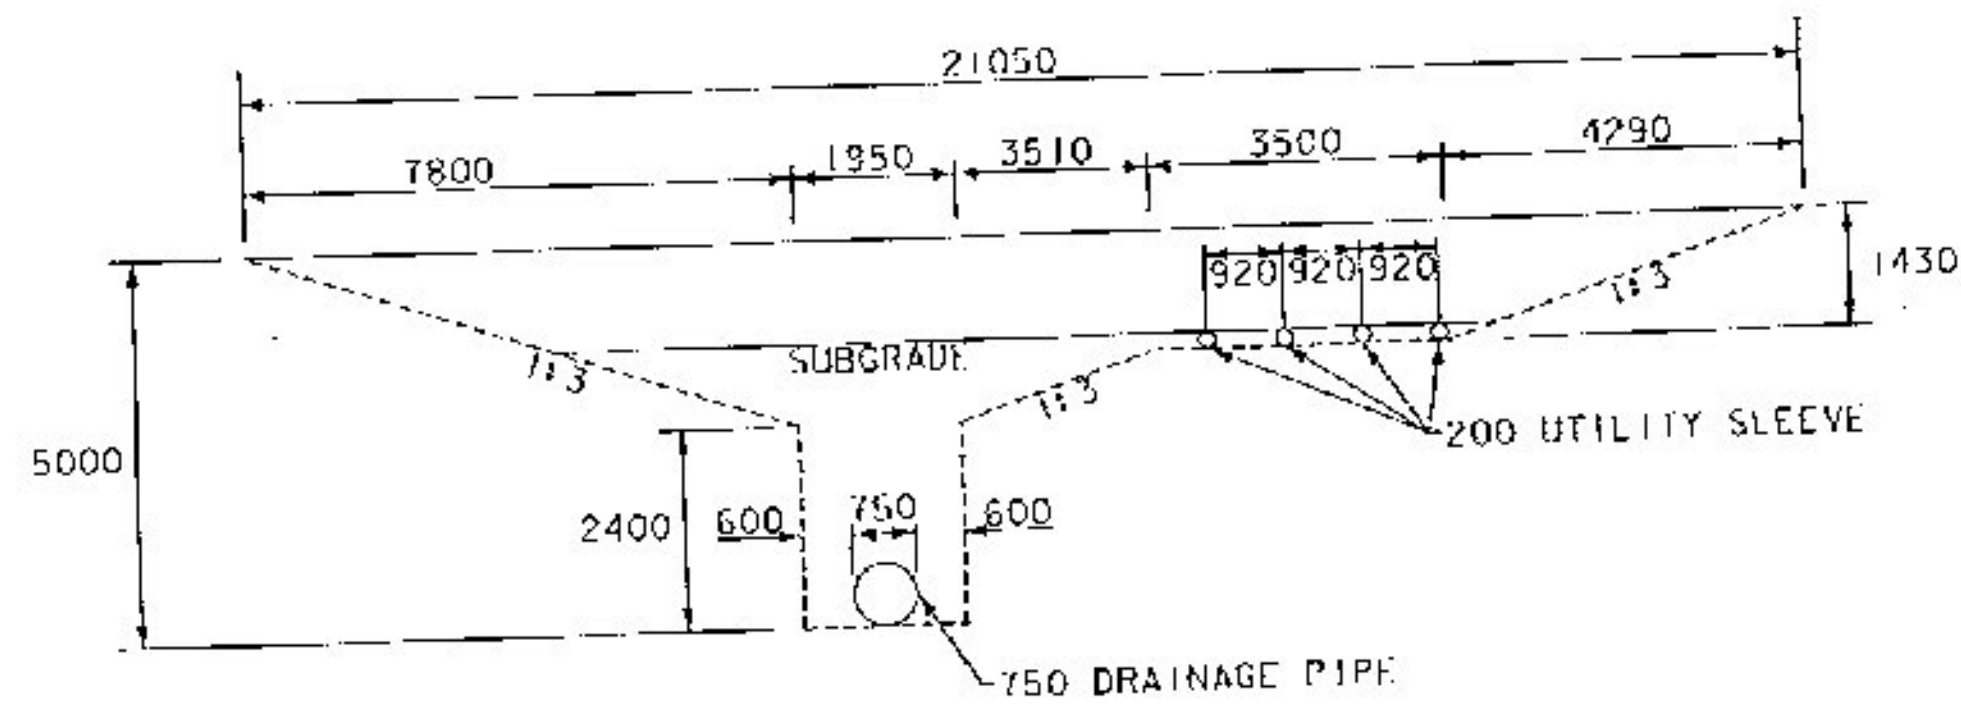


SECTION A-A

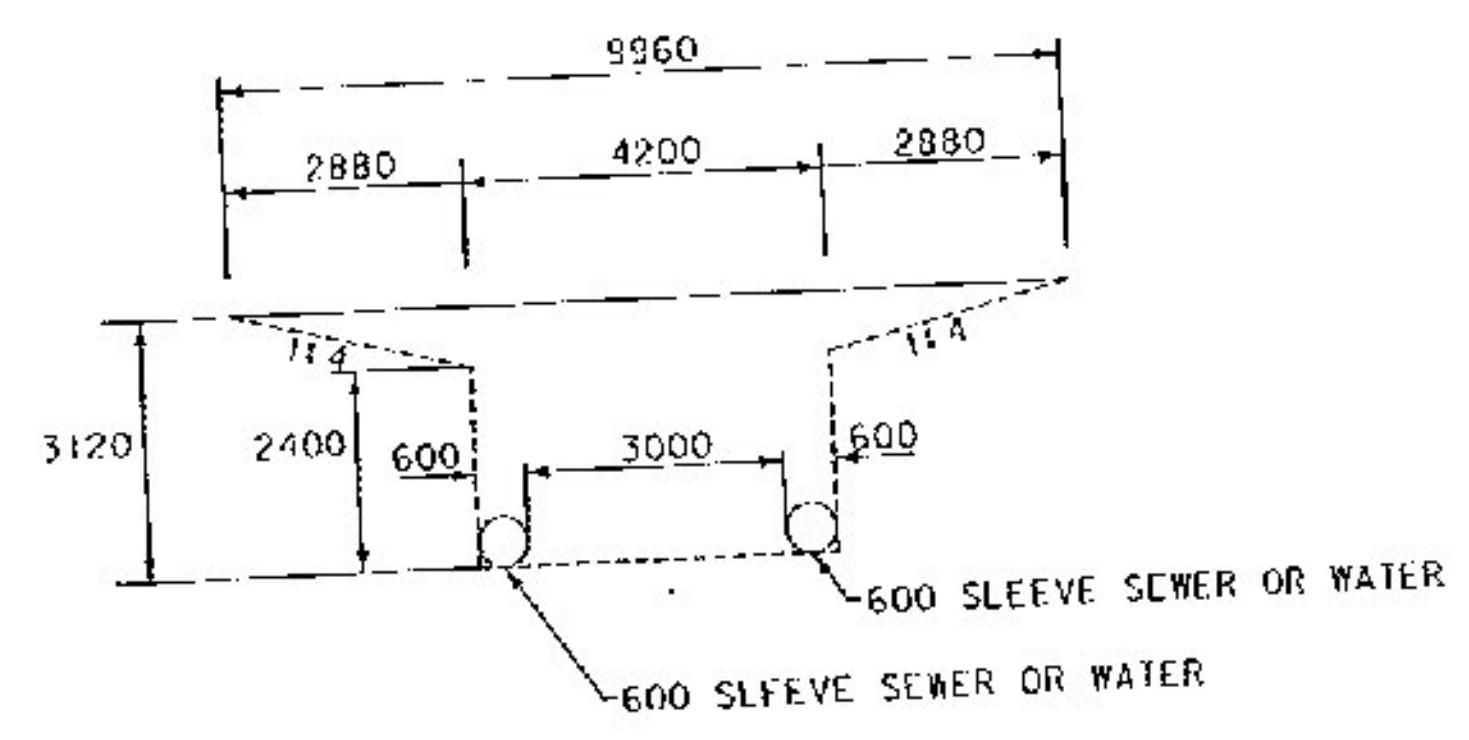

SECTION B-B

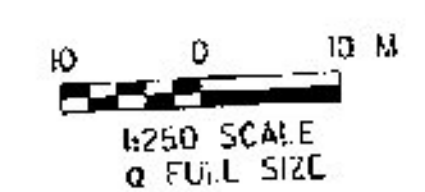

VERMONT AGENCY OF TRANSPORTATION



PROJECT NAME:	BENNINGTON
PROJECT NUMBER:	NH 019-BB41(54)
FILE NAME:	...contract_412d307c4wrk_1sm.dgn
DESIGN SUPERVISOR:	GREG EDWARDS
DESIGNED BY:	WANG FOISY
UTILITY SLEEVE PLAN	
PLOT DATE:	12/10/2010
DRAWN BY:	STANTEC
CHECKED BY:	GARY SAHIT
SHEET	1 OF 1