


SECTION C-C

Utility Sleeve  
 Revisions



SECTION D-D

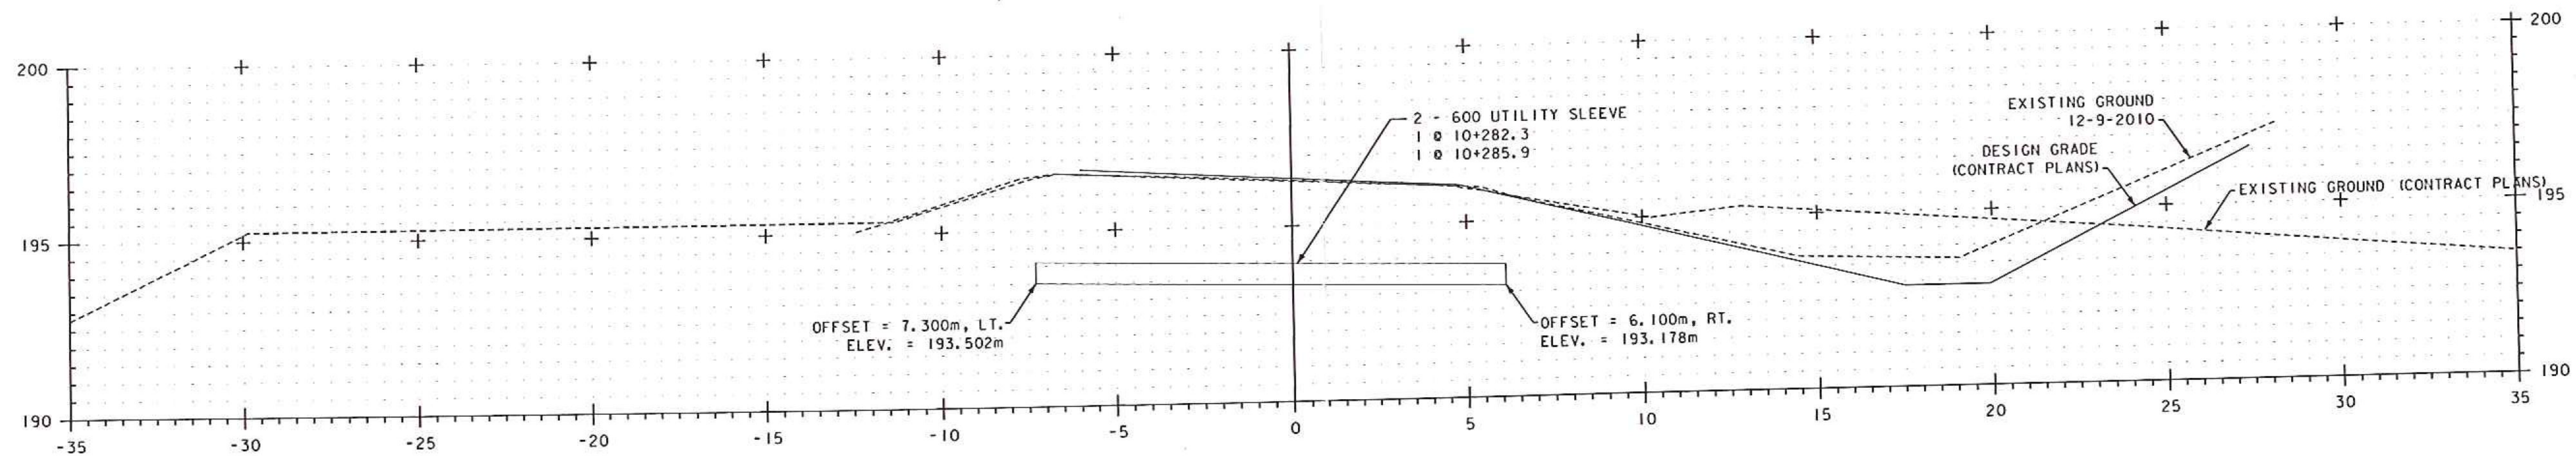

PROJECT NAME: BENNINGTON  
 PROJECT NUMBER: NH 019-1(54)

FILE NAME: ...contract\_4\zd307c4wrk.lsm.dgn PLOT DATE: 12/10/2010  
 DESIGN SUPERVISOR: GREG EDWARDS DRAWN BY: STANTEC  
 DESIGNED BY: MARC FOISY CHECKED BY: GARY SANTY  
 SECTIONS C-D AND D-D SHEET 1 OF 1