

REMOVAL AND DISPOSAL OF GUARDRAIL
 STA. SB 9+750.1, 4.0m LT. - STA. SB 9+970.0, 2.3m LT.
 STA. SB 9+912.6, 8.1m RT. - STA. SB 9+970.0, 5.6m RT.

STEEL BEAM GUARDRAIL, GALVANIZED
 STA. SB 9+760.0, 1.8m LT. - STA. SB 9+970.0, 1.8m LT.
 STA. NB 9+760.5, 6.0m RT. - STA. NB 9+790.0, 6.0m RT.
 STA. L 1+085.8, 1.8m RT. - STA. L 1+260.0, 1.8m RT.

BITUMINOUS CONCRETE CURB, TYPE A
 STA. SB 9+760.0, 1.8m LT. - STA. SB 9+970.0, 1.8m LT.
 STA. NB 9+760.5, 6.0m RT. - STA. NB 9+790.0, 6.0m RT.
 STA. L 1+085.8, 1.8m RT. - STA. L 1+260.0, 1.8m RT.

MANUFACTURED TERMINAL SECTION, FLARED
 STA. NB 9+749.1, 6.0m RT. - NB 9+760.5, 6.0m RT.
 STA. L 1+074.4, 1.8m RT. - L 1+085.8, 1.8m RT.




ANCHOR FOR STEEL BEAM RAIL
 STA. SB 9+760.0, 6.6m LT.
 STA. L 1+260.0, 1.8m RT.

REMOVING AND RESETTING FENCE
 STA. L 1+137.2, 12.2m LT - L 1+280.0, 9.7m LT.
 STA. NB 9+713.4, 14.8m RT - NB 9+731.6, 15.0m RT.

REMOVING AND RESETTING CURB
 STA. NB 9+520.0, 0.3m LT. - NB 9+790.0, 0.3m LT.
 STA. NB 9+520.0, 5.1m LT. - NB 9+790.0, 5.1m LT.
 STA. NB 9+596.0, 5.1m LT. - NB 9+680.0, 10.5m LT.

PROJECT DEMARCATION FENCE
 STA. SB 9+747.0, LT. - STA. SB 9+970.0, LT.
 STA. SB 9+888.2, RT. - STA. SB 9+970.0, RT.
 STA. NB 9+726.8, LT. - STA. NB 9+790.0, LT.
 STA. L 1+000.0, RT. - STA. L 1+280.0, RT.

BARRIER FENCE
 STA. SB 9+951.9, LT. - STA. SB 9+970.0, LT.

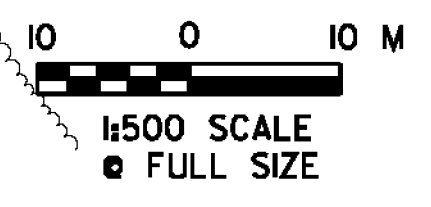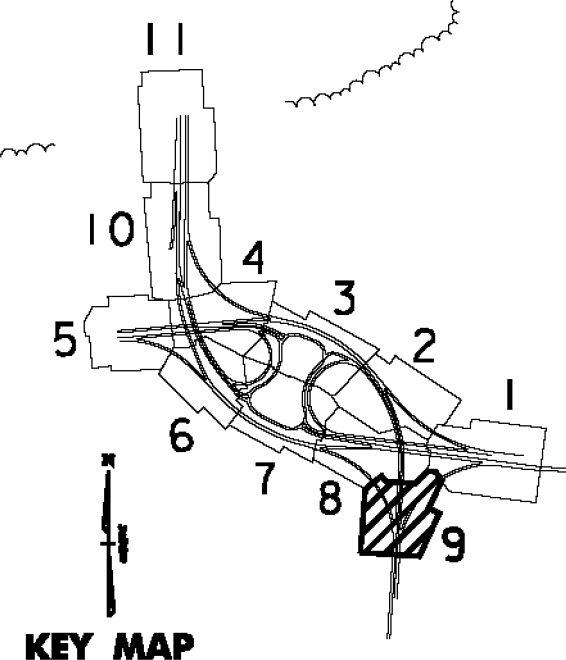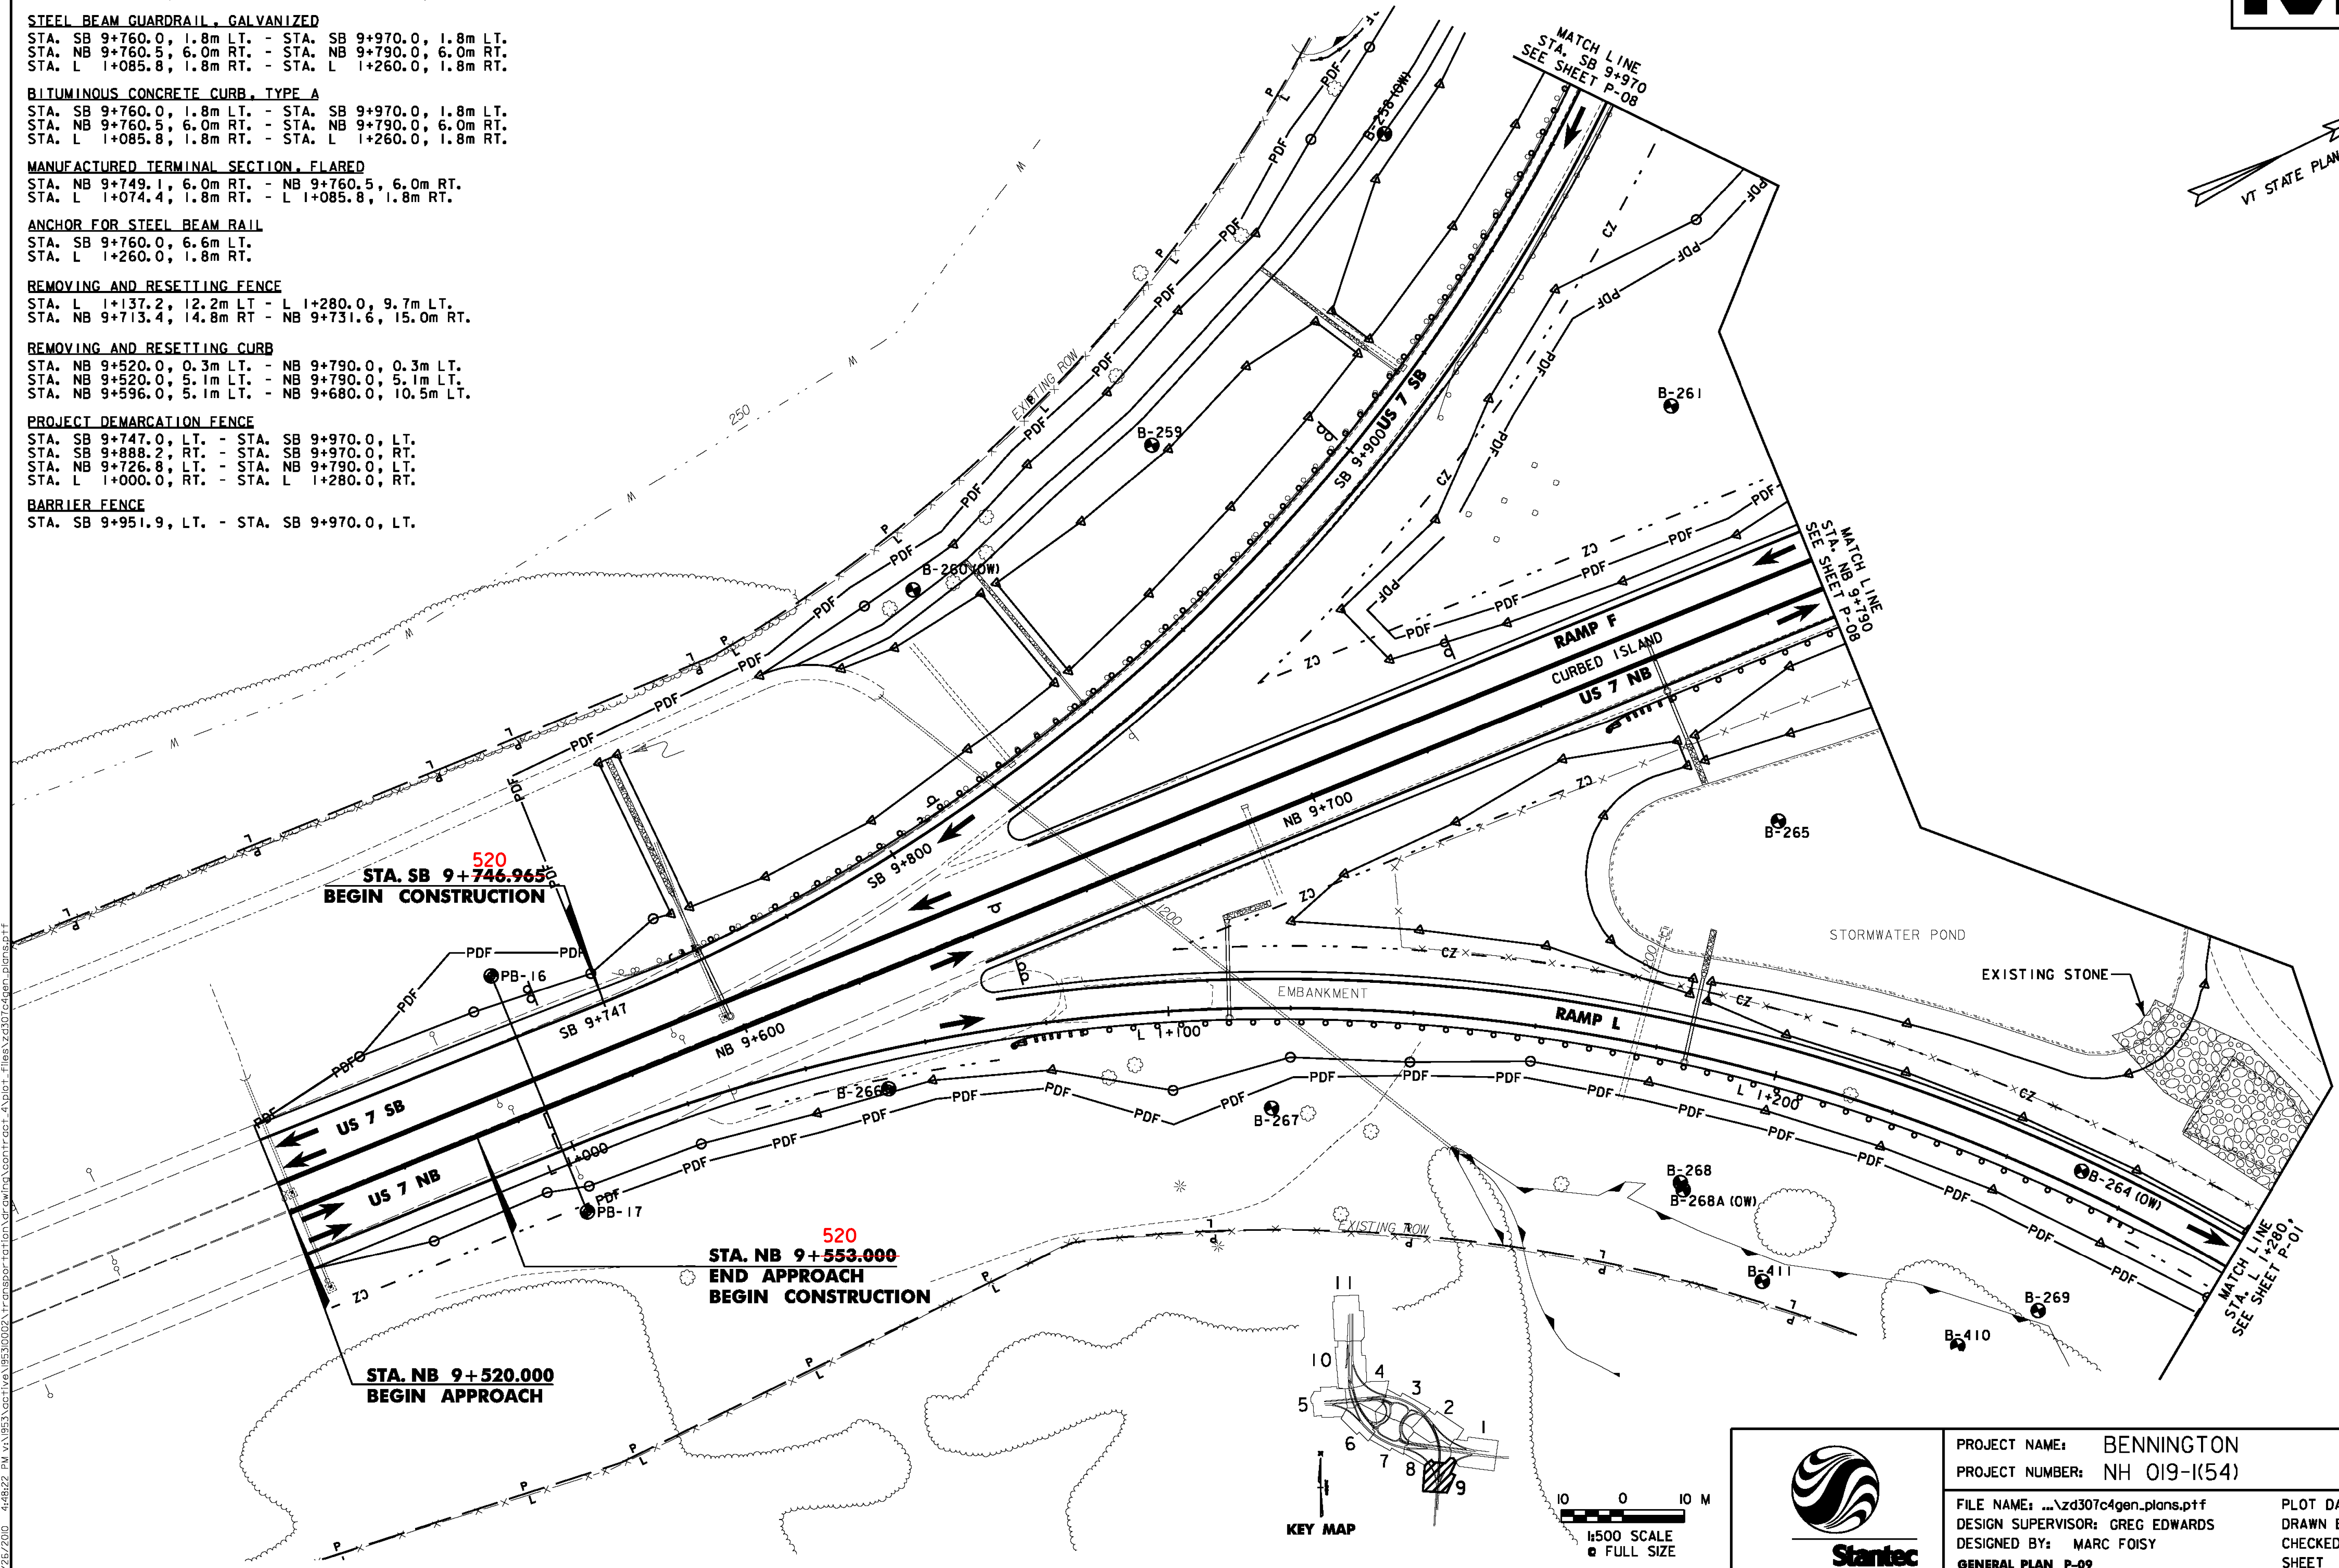

PROJECT NAME: BENNINGTON	PLOT DATE: 1/26/2010
PROJECT NUMBER: NH 019-(K54)	DRAWN BY: STANTEC
FILE NAME: ...zd307c4gen_plans.ptf	CHECKED BY: GARY SANTY
DESIGN SUPERVISOR: GREG EDWARDS	SHEET 124 OF 468
DESIGNED BY: MARC FOISY	
GENERAL PLAN P-09	

1/26/2010 4:48:22 PM v:\1953\active\19530002\transportation\drawing\com\tr\001_4\p01 - files\z6307c4gen_plans.p01