

Project: Bennington AC NH 019-1(54)

Item Code of

Item Number: 203.15 Common Excavation

Computed By: Scott Jensen

Date: 7/26/2011

Checked By:



Date:

To Field Book No.:

Page: 1

Location and profile of common excavation  
and backfilling performed on 7/26/11.

Revisions

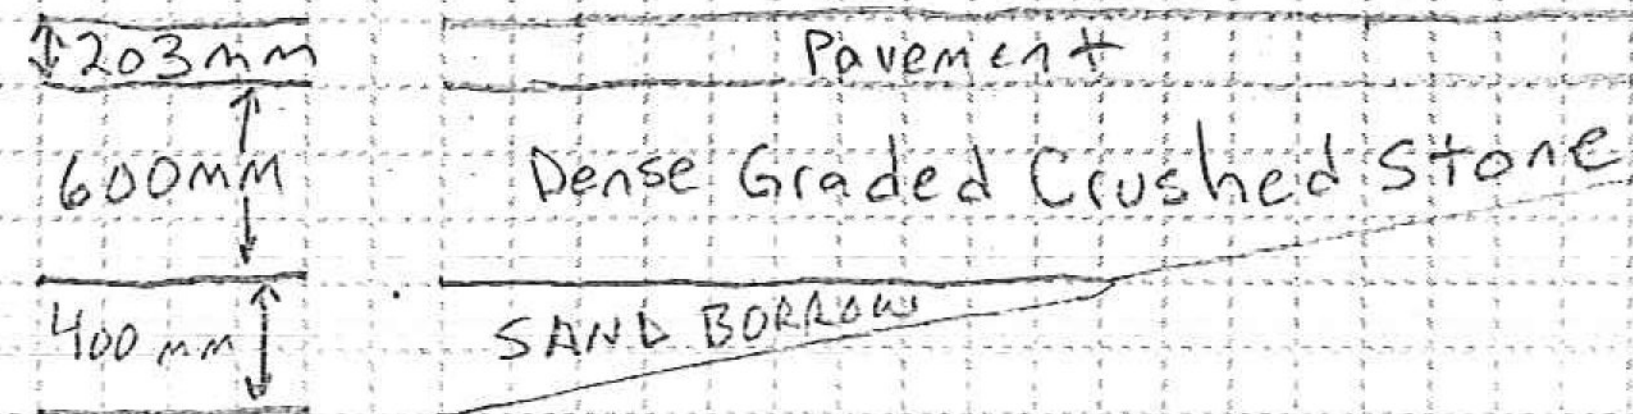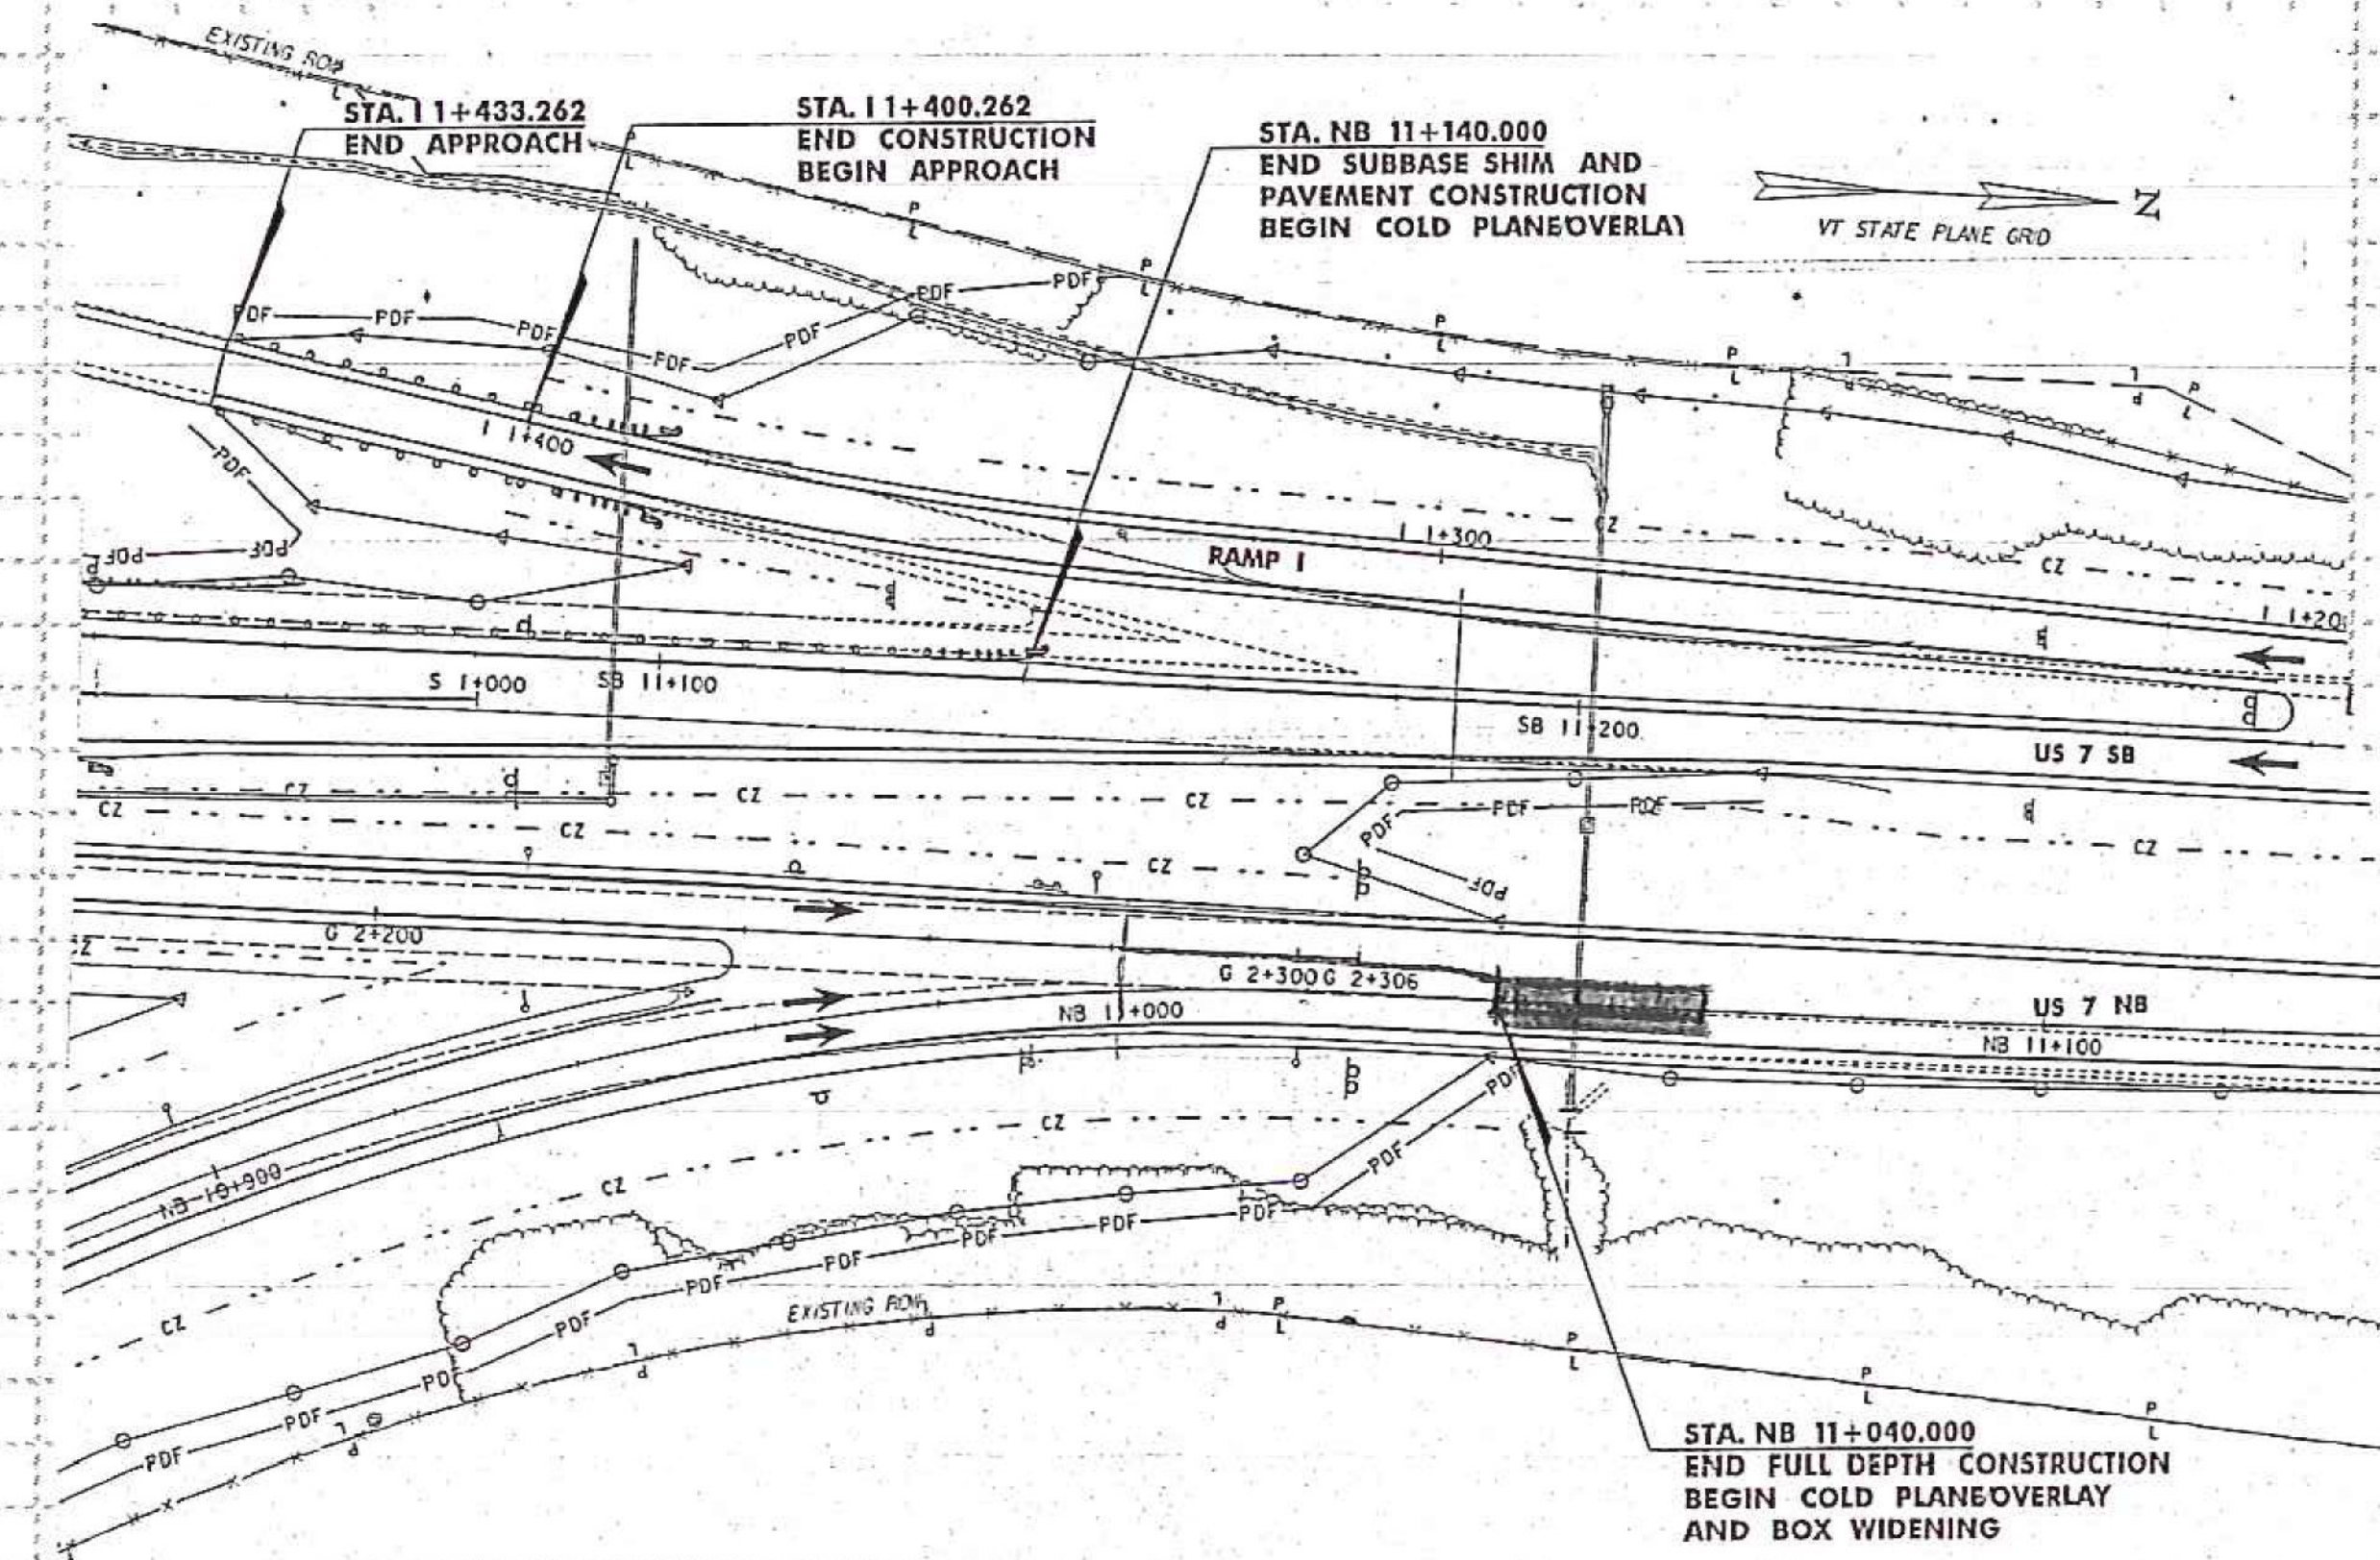

NB 11+040

NB 11+050

NB 11+065