


NOTES:


- 1.) EXISTING LILAC BUSHES (3) TO BE REMOVED AND RESET AT LOCATION TO BE AGREED UPON.
- 2.) EXISTING HICKORY TREE IS TO BE PROTECTED FROM DAMAGE.
- 3.) PROPANE TANK TO BE RELOCATED.

N/F
BOHNE

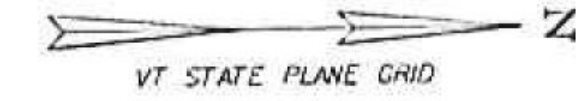


N/F
HALL

73

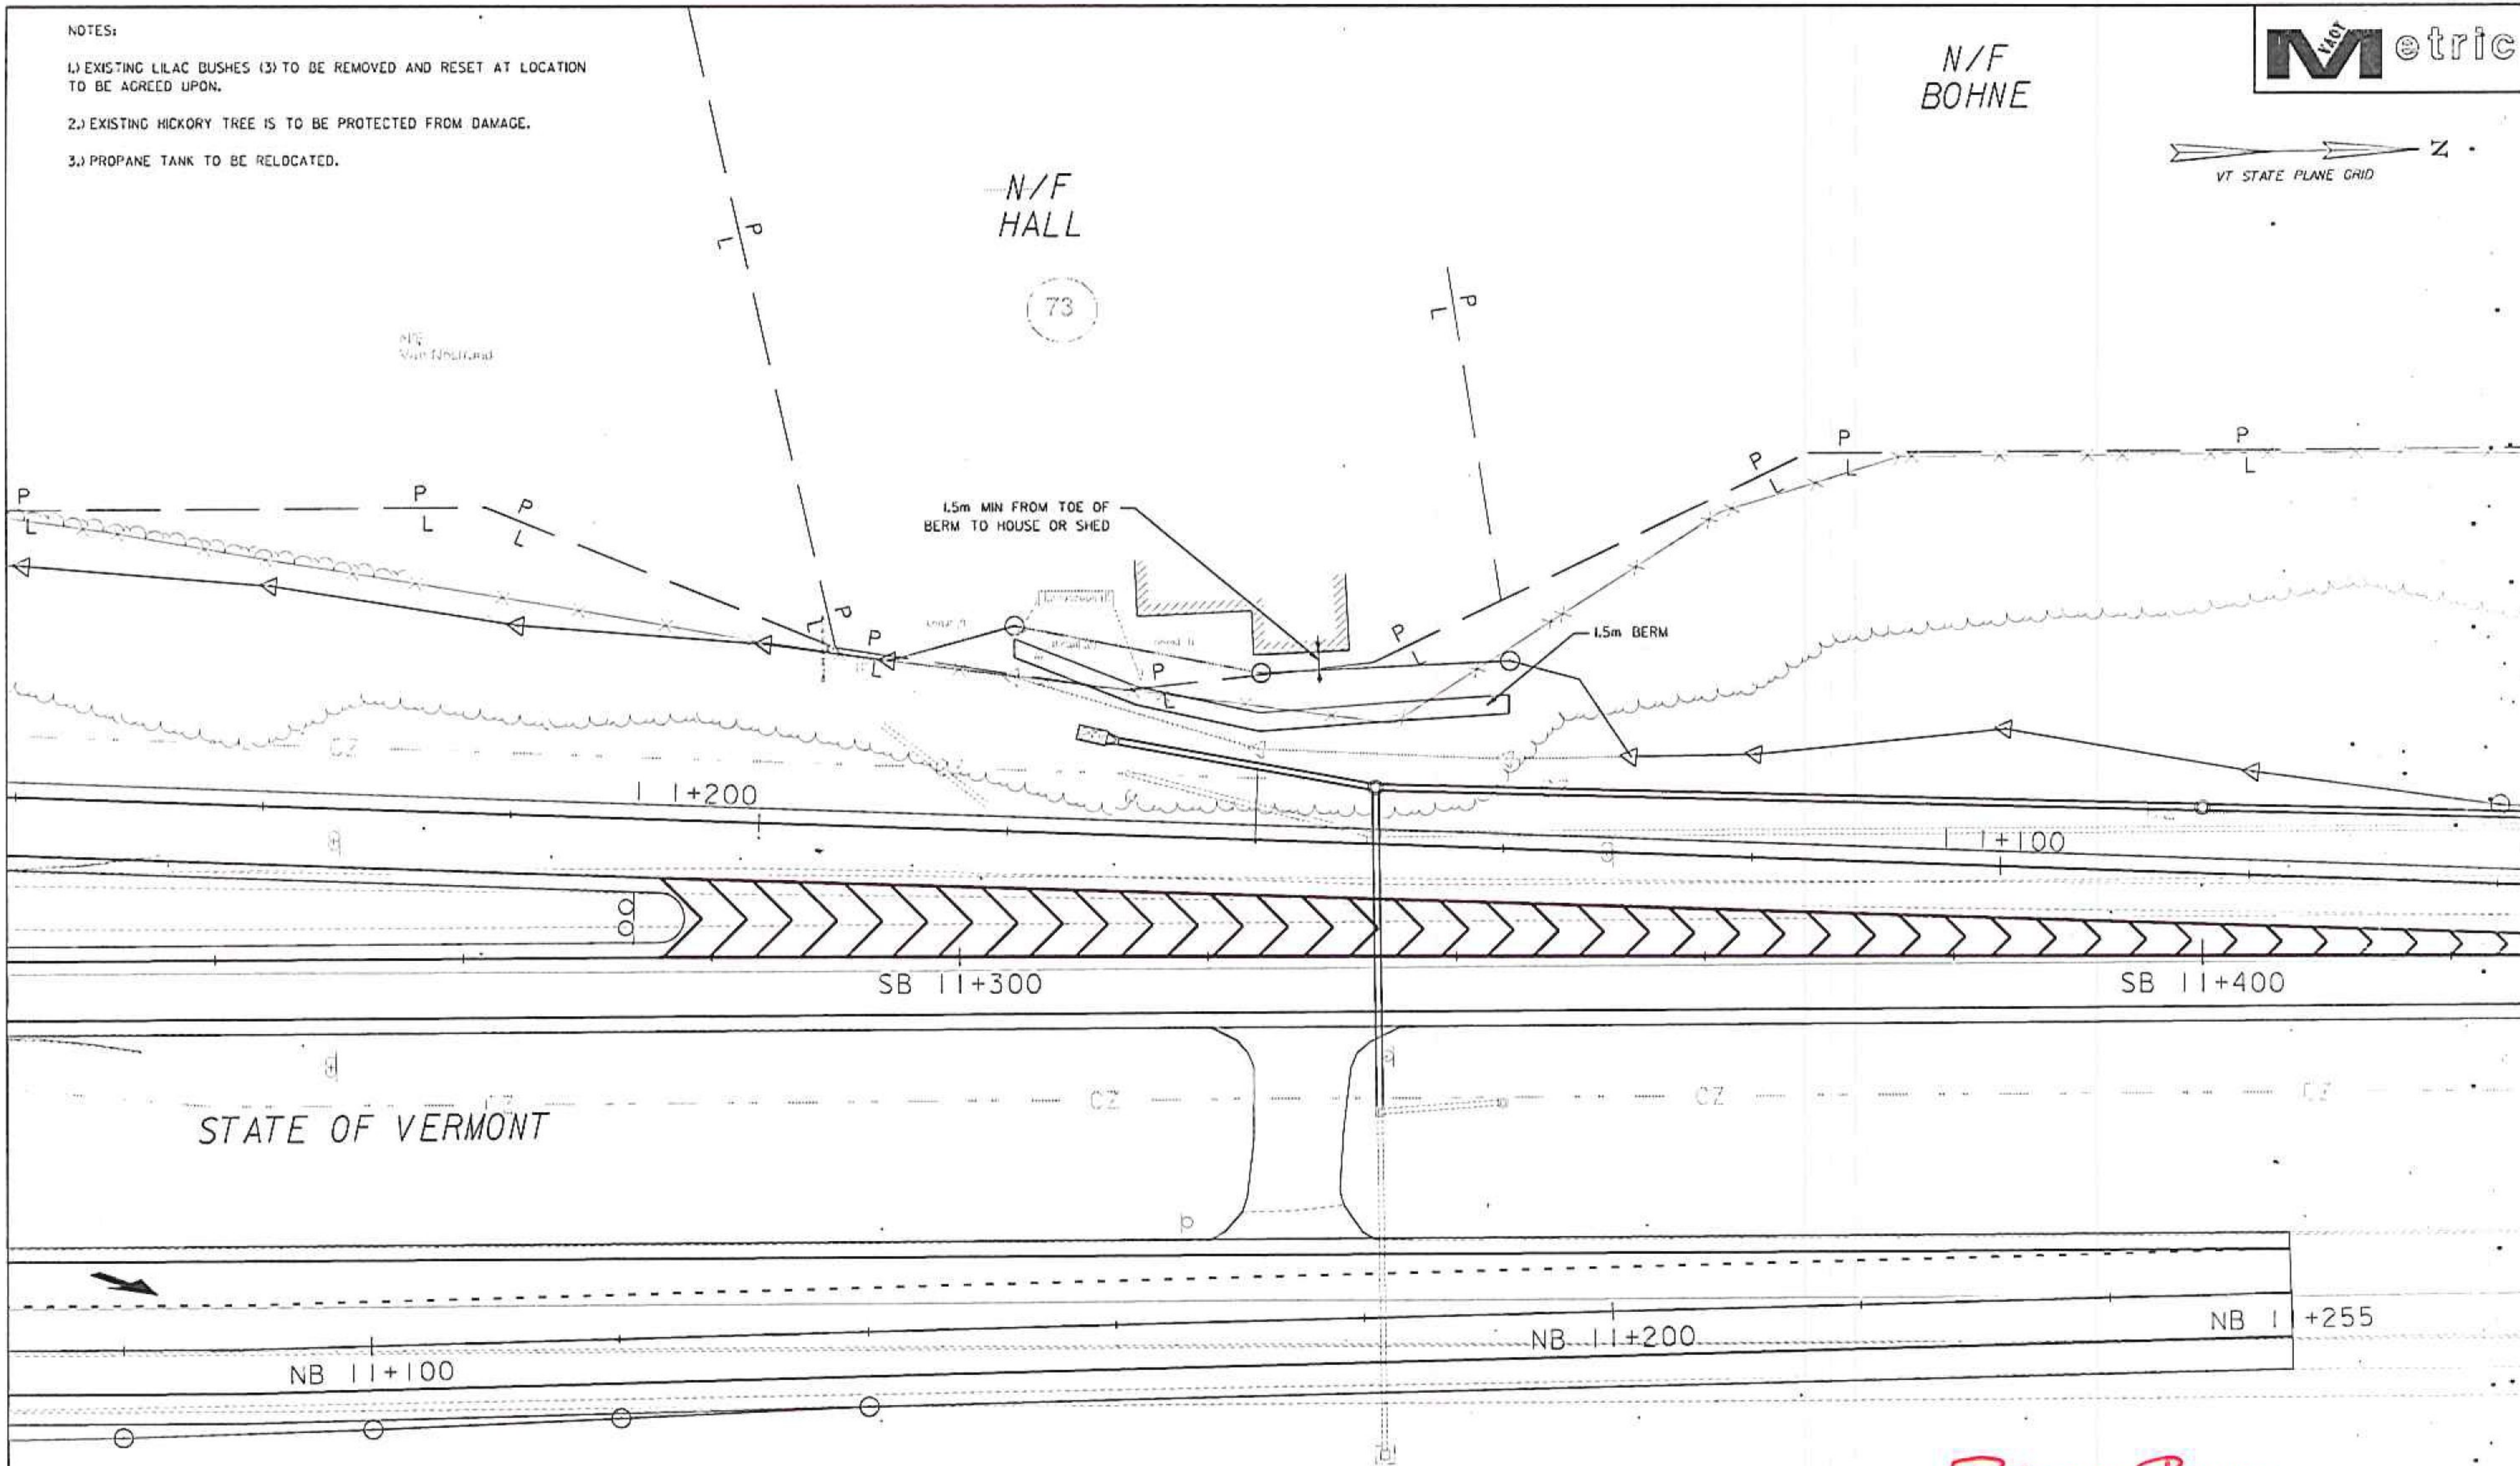

STATE OF VERMONT

RECORDED PLANS

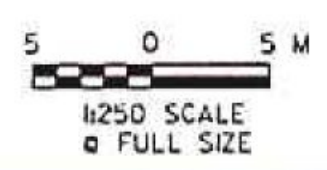

PROJECT NAME:	BENNINGTON	PLOT DATE:	5/4/2011
PROJECT NUMBER:	NH 019-1(54)	DRAWN BY:	STANTEC
FILE NAME:	...12d307c4 HallProperty.dgn	CHECKED BY:	GARY SANTY
DESIGN SUPERVISOR:	GREG EDWARDS	SHEET	1 OF 1
DESIGNED BY:	MARC FOISY		