


- NOTES**
1. SEE DRAINAGE PLAN DP-07a FOR PIPE NOTES
  2. HEADWALL TO BE INSTALLED AFTER THE TEMPORARY SEDIMENT BASIN IS NO LONGER REQUIRED. SEE EC-07 AND ECD-07 FOR DETAILS.

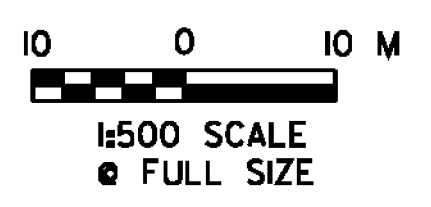

PROJECT NAME:	BENNINGTON	PLLOT DATE:	1/26/2010
PROJECT NUMBER:	NH 019-(K54)	DRAWN BY:	STANTEC
FILE NAME:	...z307c4drn.plans.ptf	CHECKED BY:	GARY SANTY
DESIGN SUPERVISOR:	GREG EDWARDS	SHEET	133 OF 468
DESIGNED BY:	MARC FOISY		
DRAINAGE PLANS DP-07			

1/26/2010 4:48:43 PM v:\951\del\va\9510002\tr\transport\station\dr\w\ng\com\tr\cst\_4\p\cst\_4\files\z307c4drn.plans.ptf