


# PIPE 209 REVISIONS

PIPE 209 SHORTENED, 12 m +/-  
TO ACCOMMODATE PRE-TREATMENT  
FOR SWALE 2A

E:\2007\2007\338.00 Bennington Bypass\Bennington Bypass\Contract 54\Drawings\Pipe 209 Outlet Stone Fill Type II 02-27-13.dgn

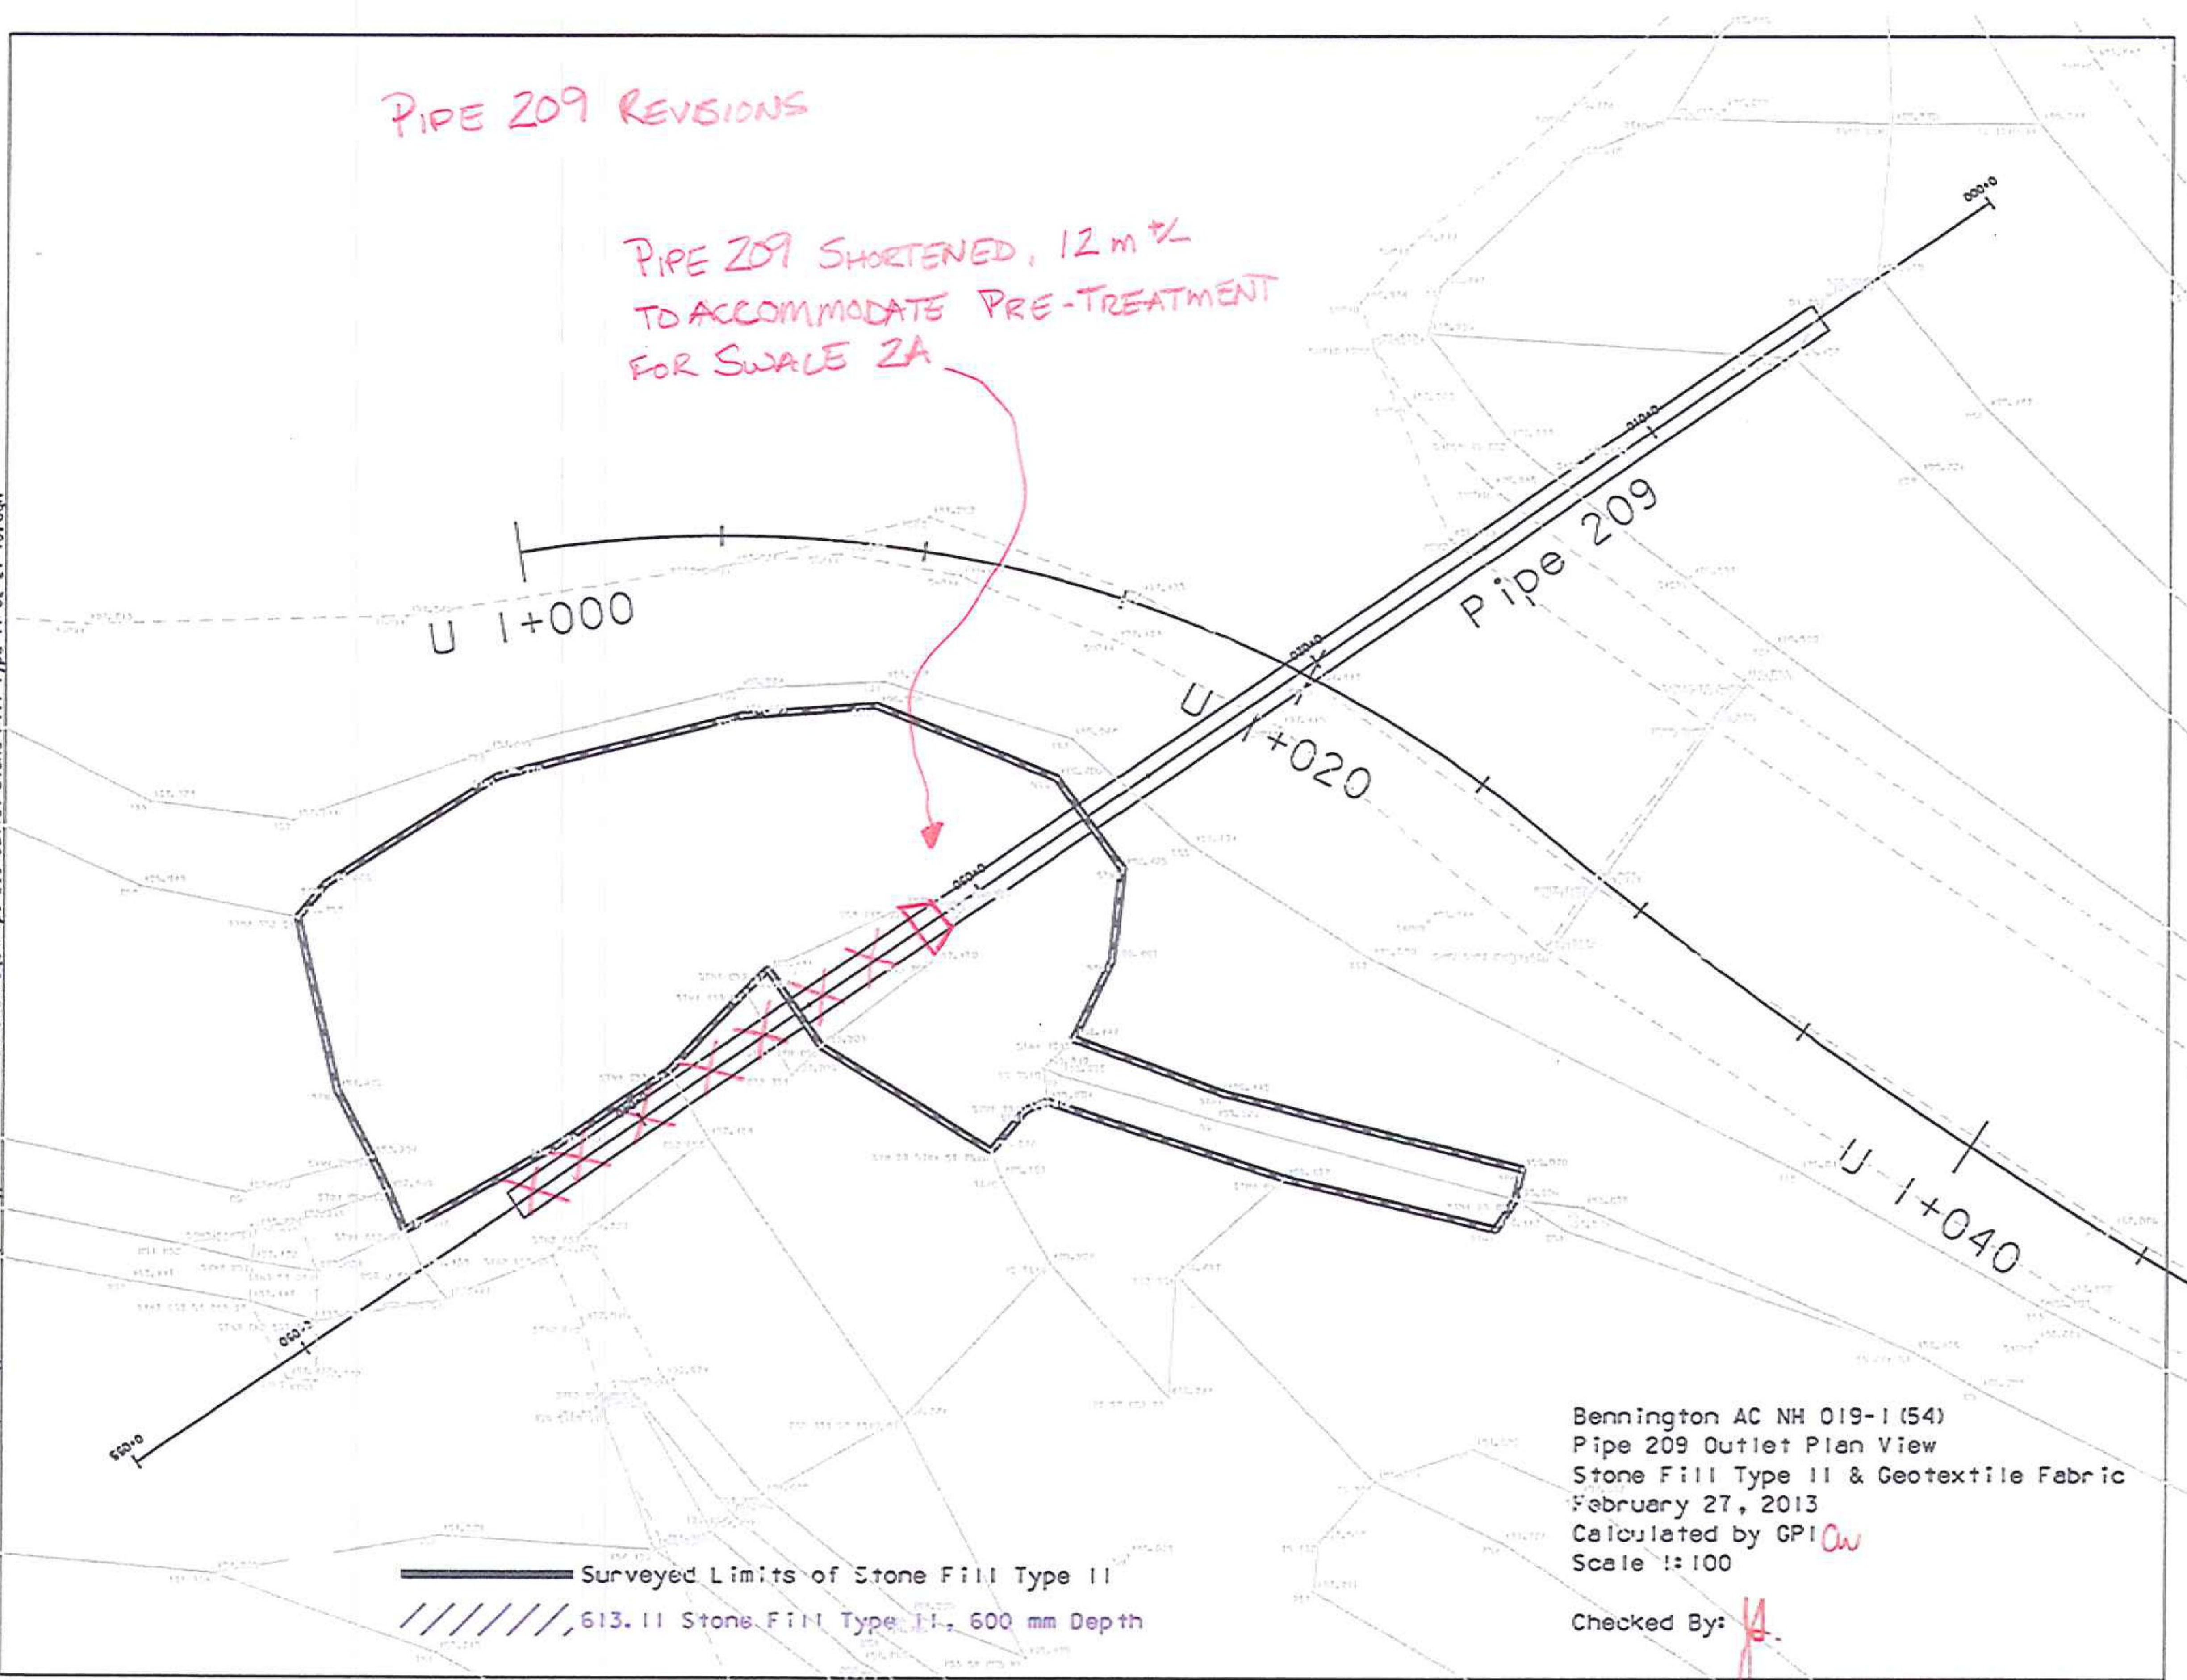

————— Surveyed Limits of Stone Fill Type II  
////// 613.11 Stone Fill Type I, 600 mm Depth

Bennington AC NH 019-1 (54)  
Pipe 209 Outlet Plan View  
Stone Fill Type II & Geotextile Fabric  
February 27, 2013  
Calculated by GPI *CW*  
Scale 1:100

Checked By: *[Signature]*