
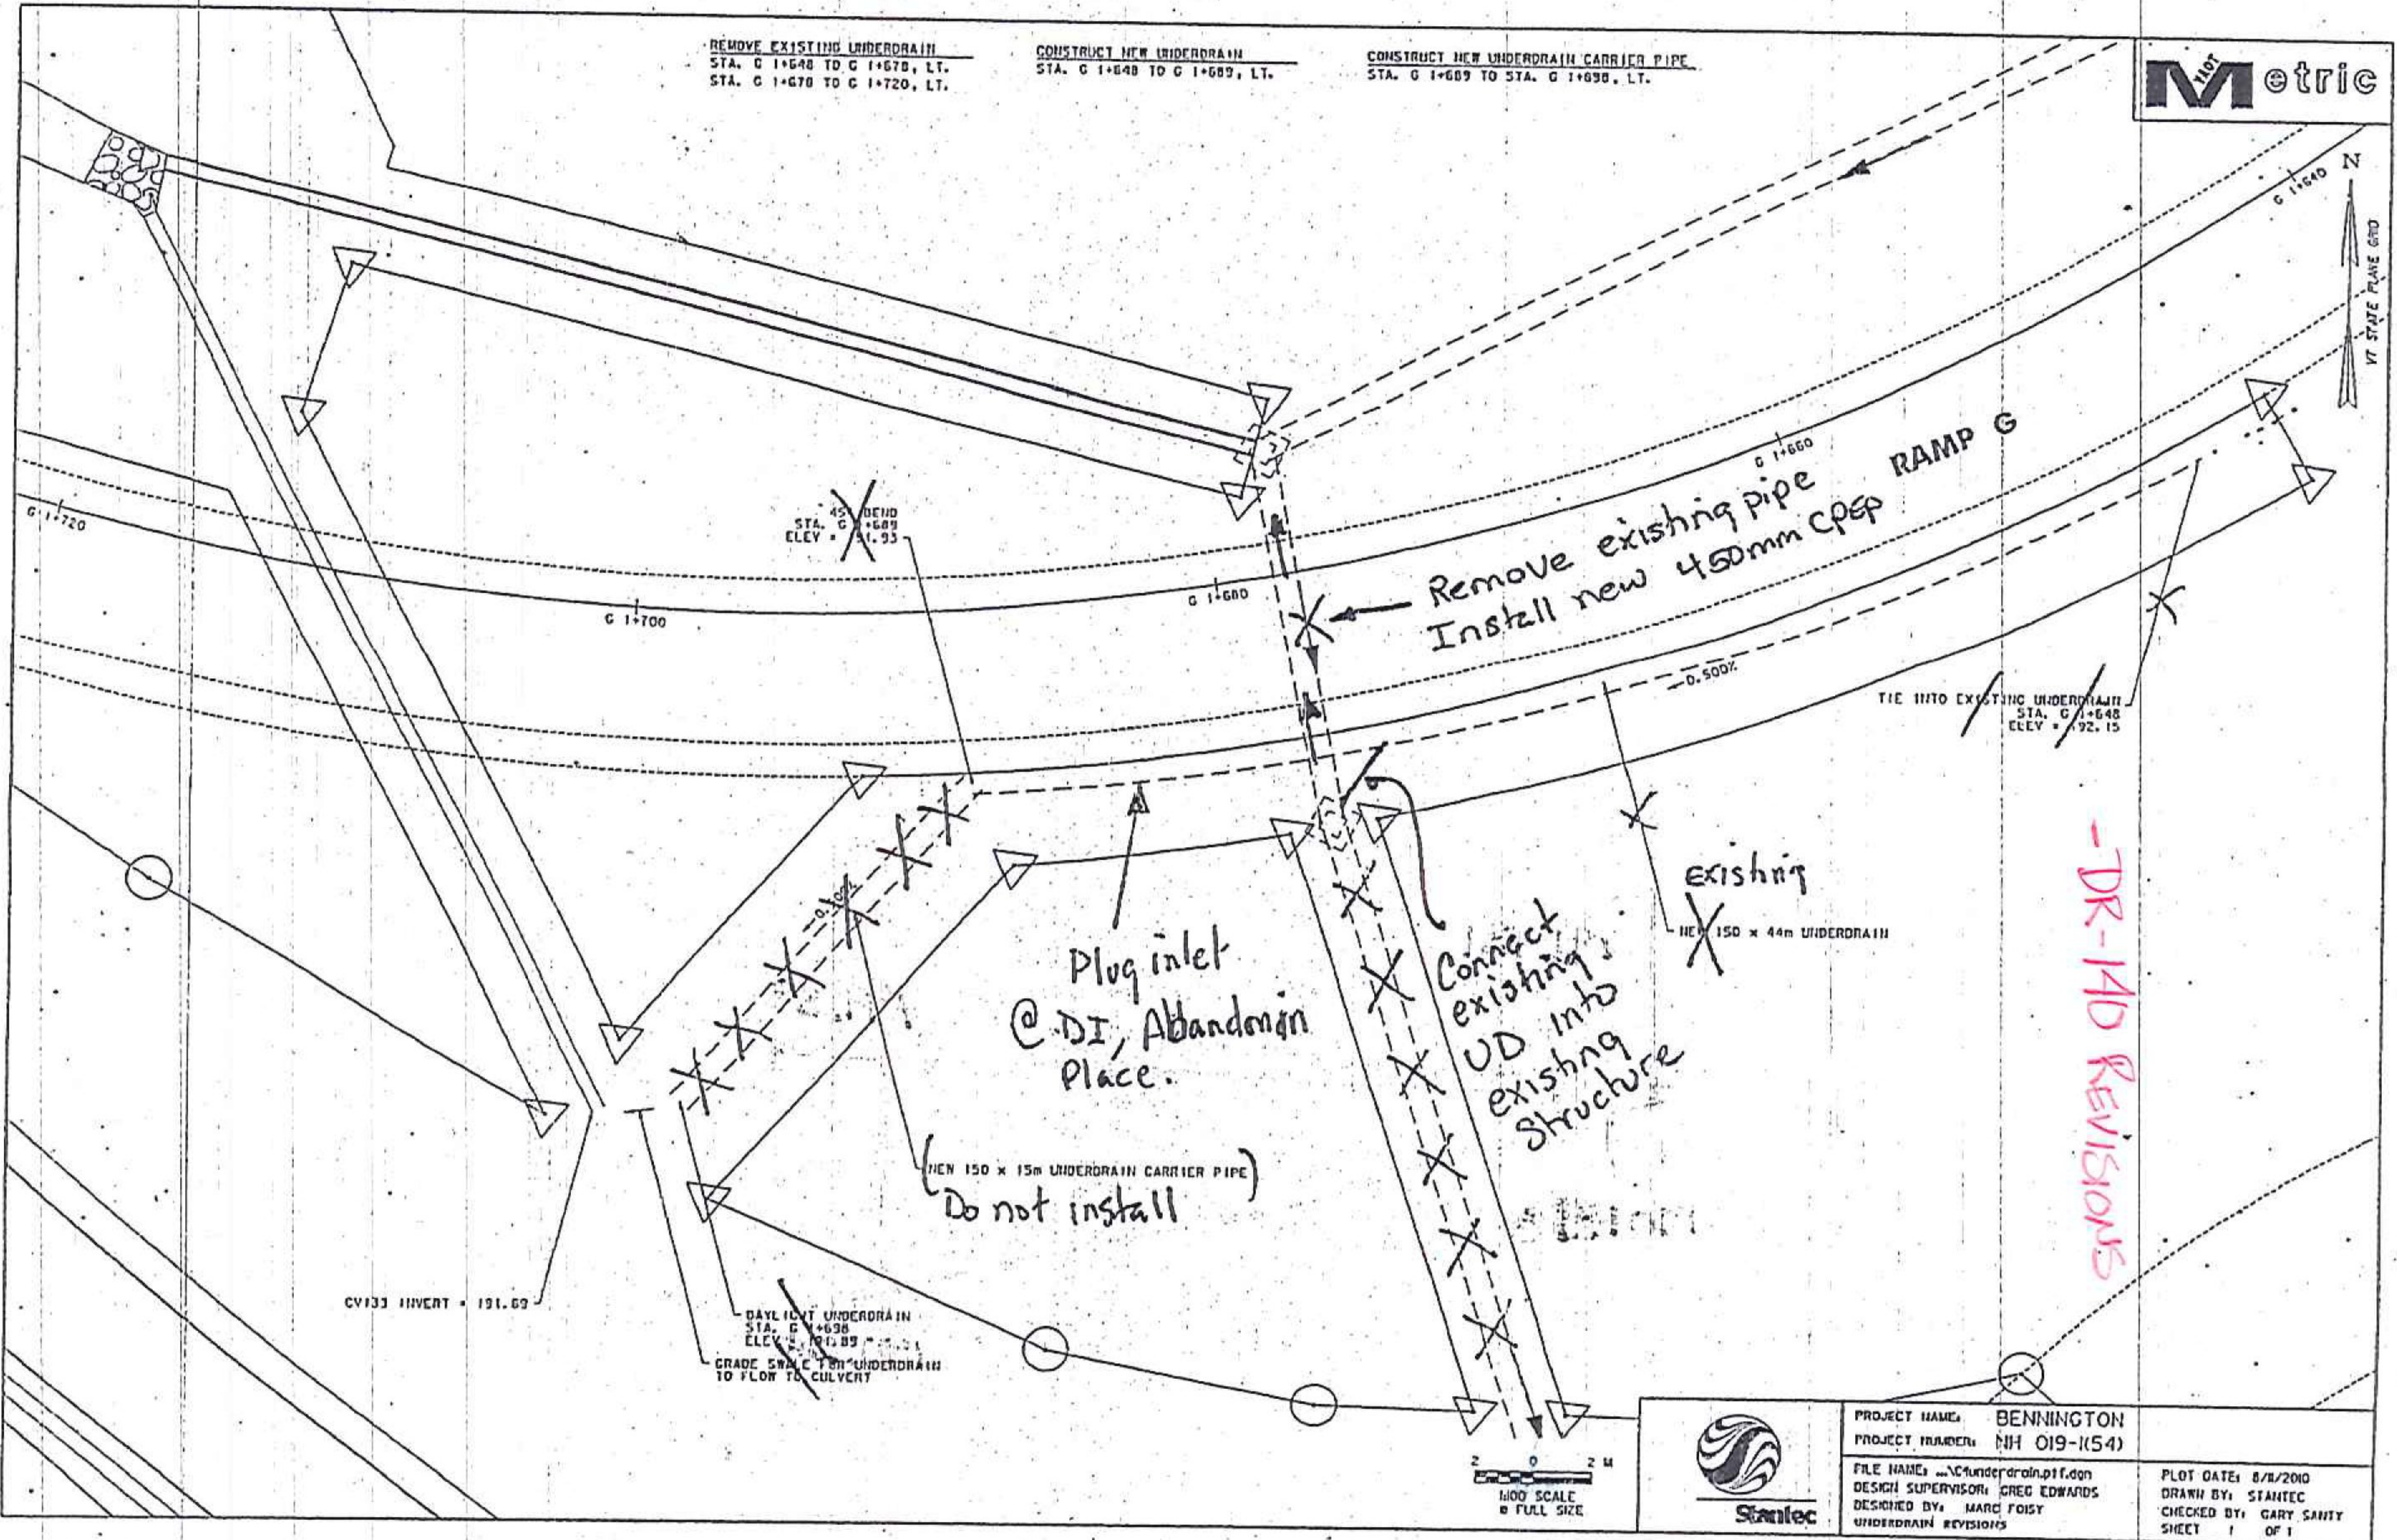


REMOVE EXISTING UNDERDRAIN  
STA. C 1+648 TO C 1+678, LT.  
STA. C 1+678 TO C 1+720, LT.

CONSTRUCT NEW UNDERDRAIN  
STA. C 1+648 TO C 1+689, LT.

CONSTRUCT NEW UNDERDRAIN CARRIER PIPE  
STA. C 1+689 TO STA. C 1+698, LT.

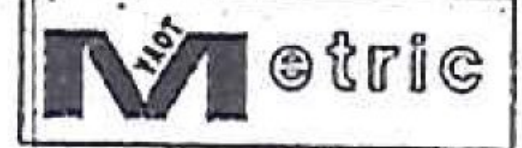

-DR-1AD REVISIONS



PROJECT NAME: BENNINGTON  
PROJECT NUMBER: NH 019-1(54)  
FILE NAME: \\c:\underdrain\p1.dgn  
DESIGN SUPERVISOR: GREG EDWARDS  
DESIGNED BY: MARC FOIST  
UNDERDRAIN REVISIONS

PLOT DATE: 8/8/2010  
DRAWN BY: STANTEC  
CHECKED BY: GARY SANIT  
SHEET 1 OF 1