

AS BUILT

Project: Bennington AC NH 019-1(54)

Item Code of

Item Number:

Date:


Computed By:

Date:

Checked By:

Page:

To Field Book No.:

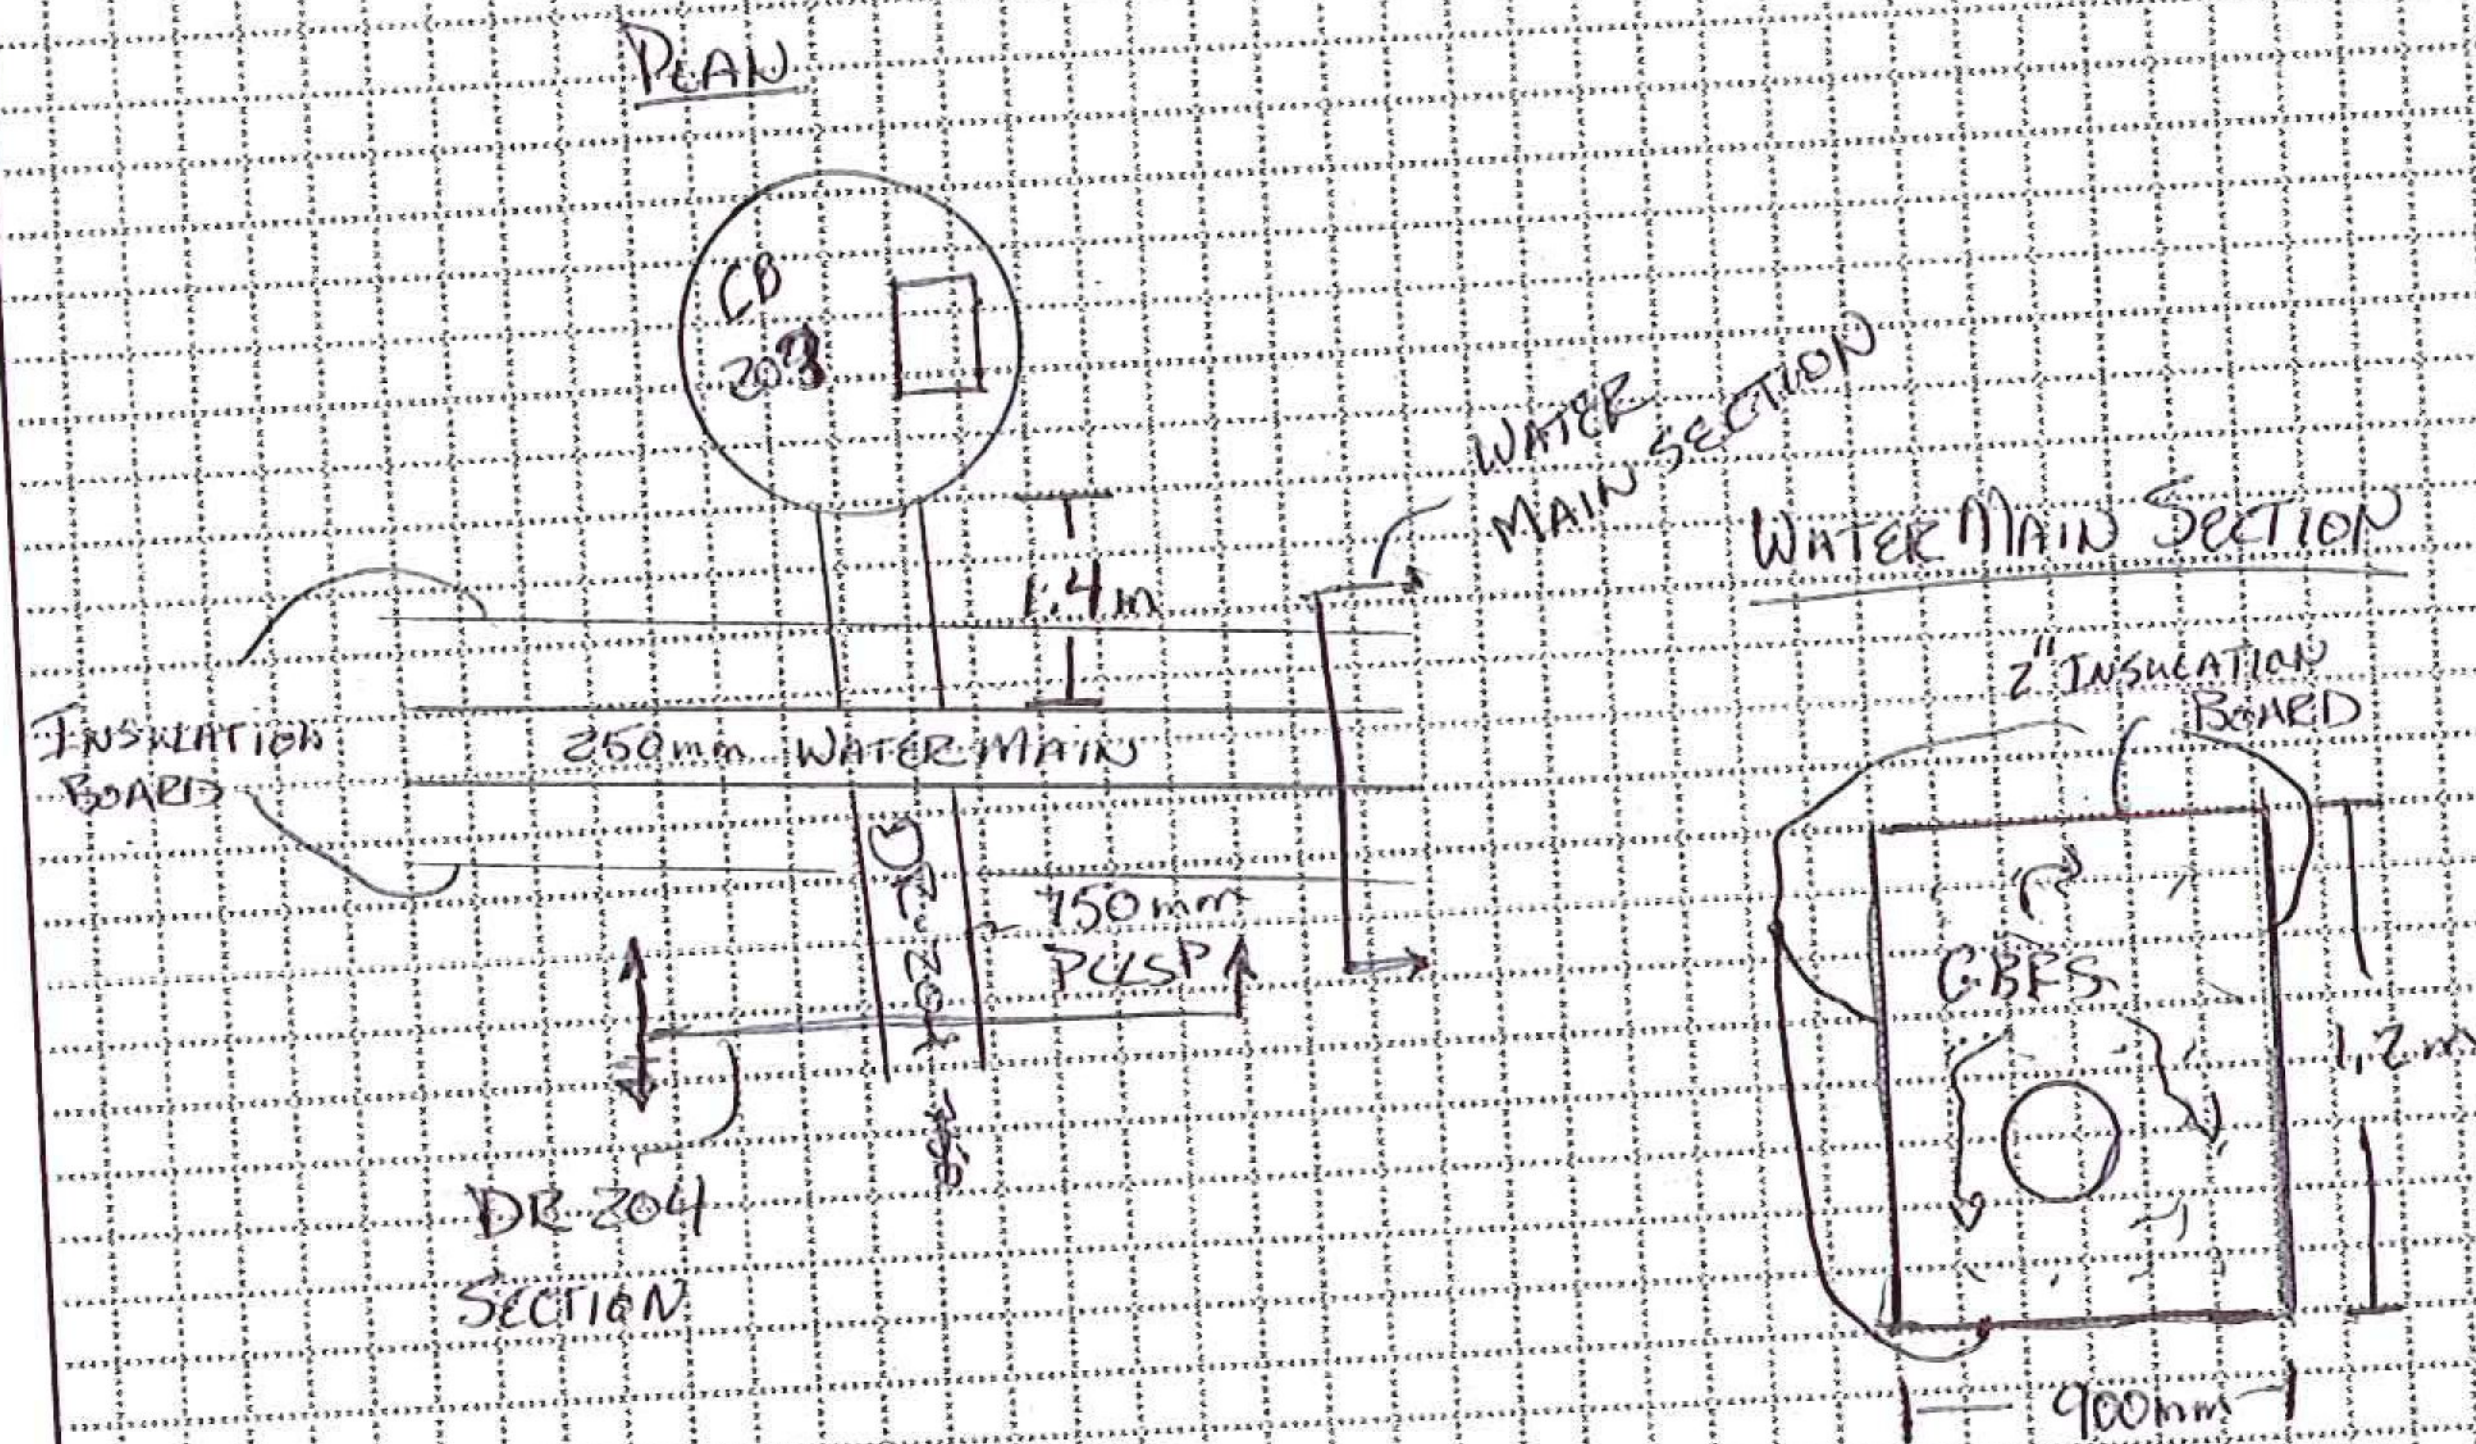

*ELEV OF WATER MAIN

@ CROSSING = 190.70

TOP OF PIPE

DR 204 SECTION

