

Project: Bennington AC, NH 019-1(54)

Item Code _____ of _____

Item Number: **DL 131 MODIFICATION - AS BUILT SKETCH**

Computed By: _____

Date: _____


Checked By: _____

Date: _____

To Field Book No.: _____

Page: _____

DL 131 MODIFICATION FOR FRAME AND GRATE

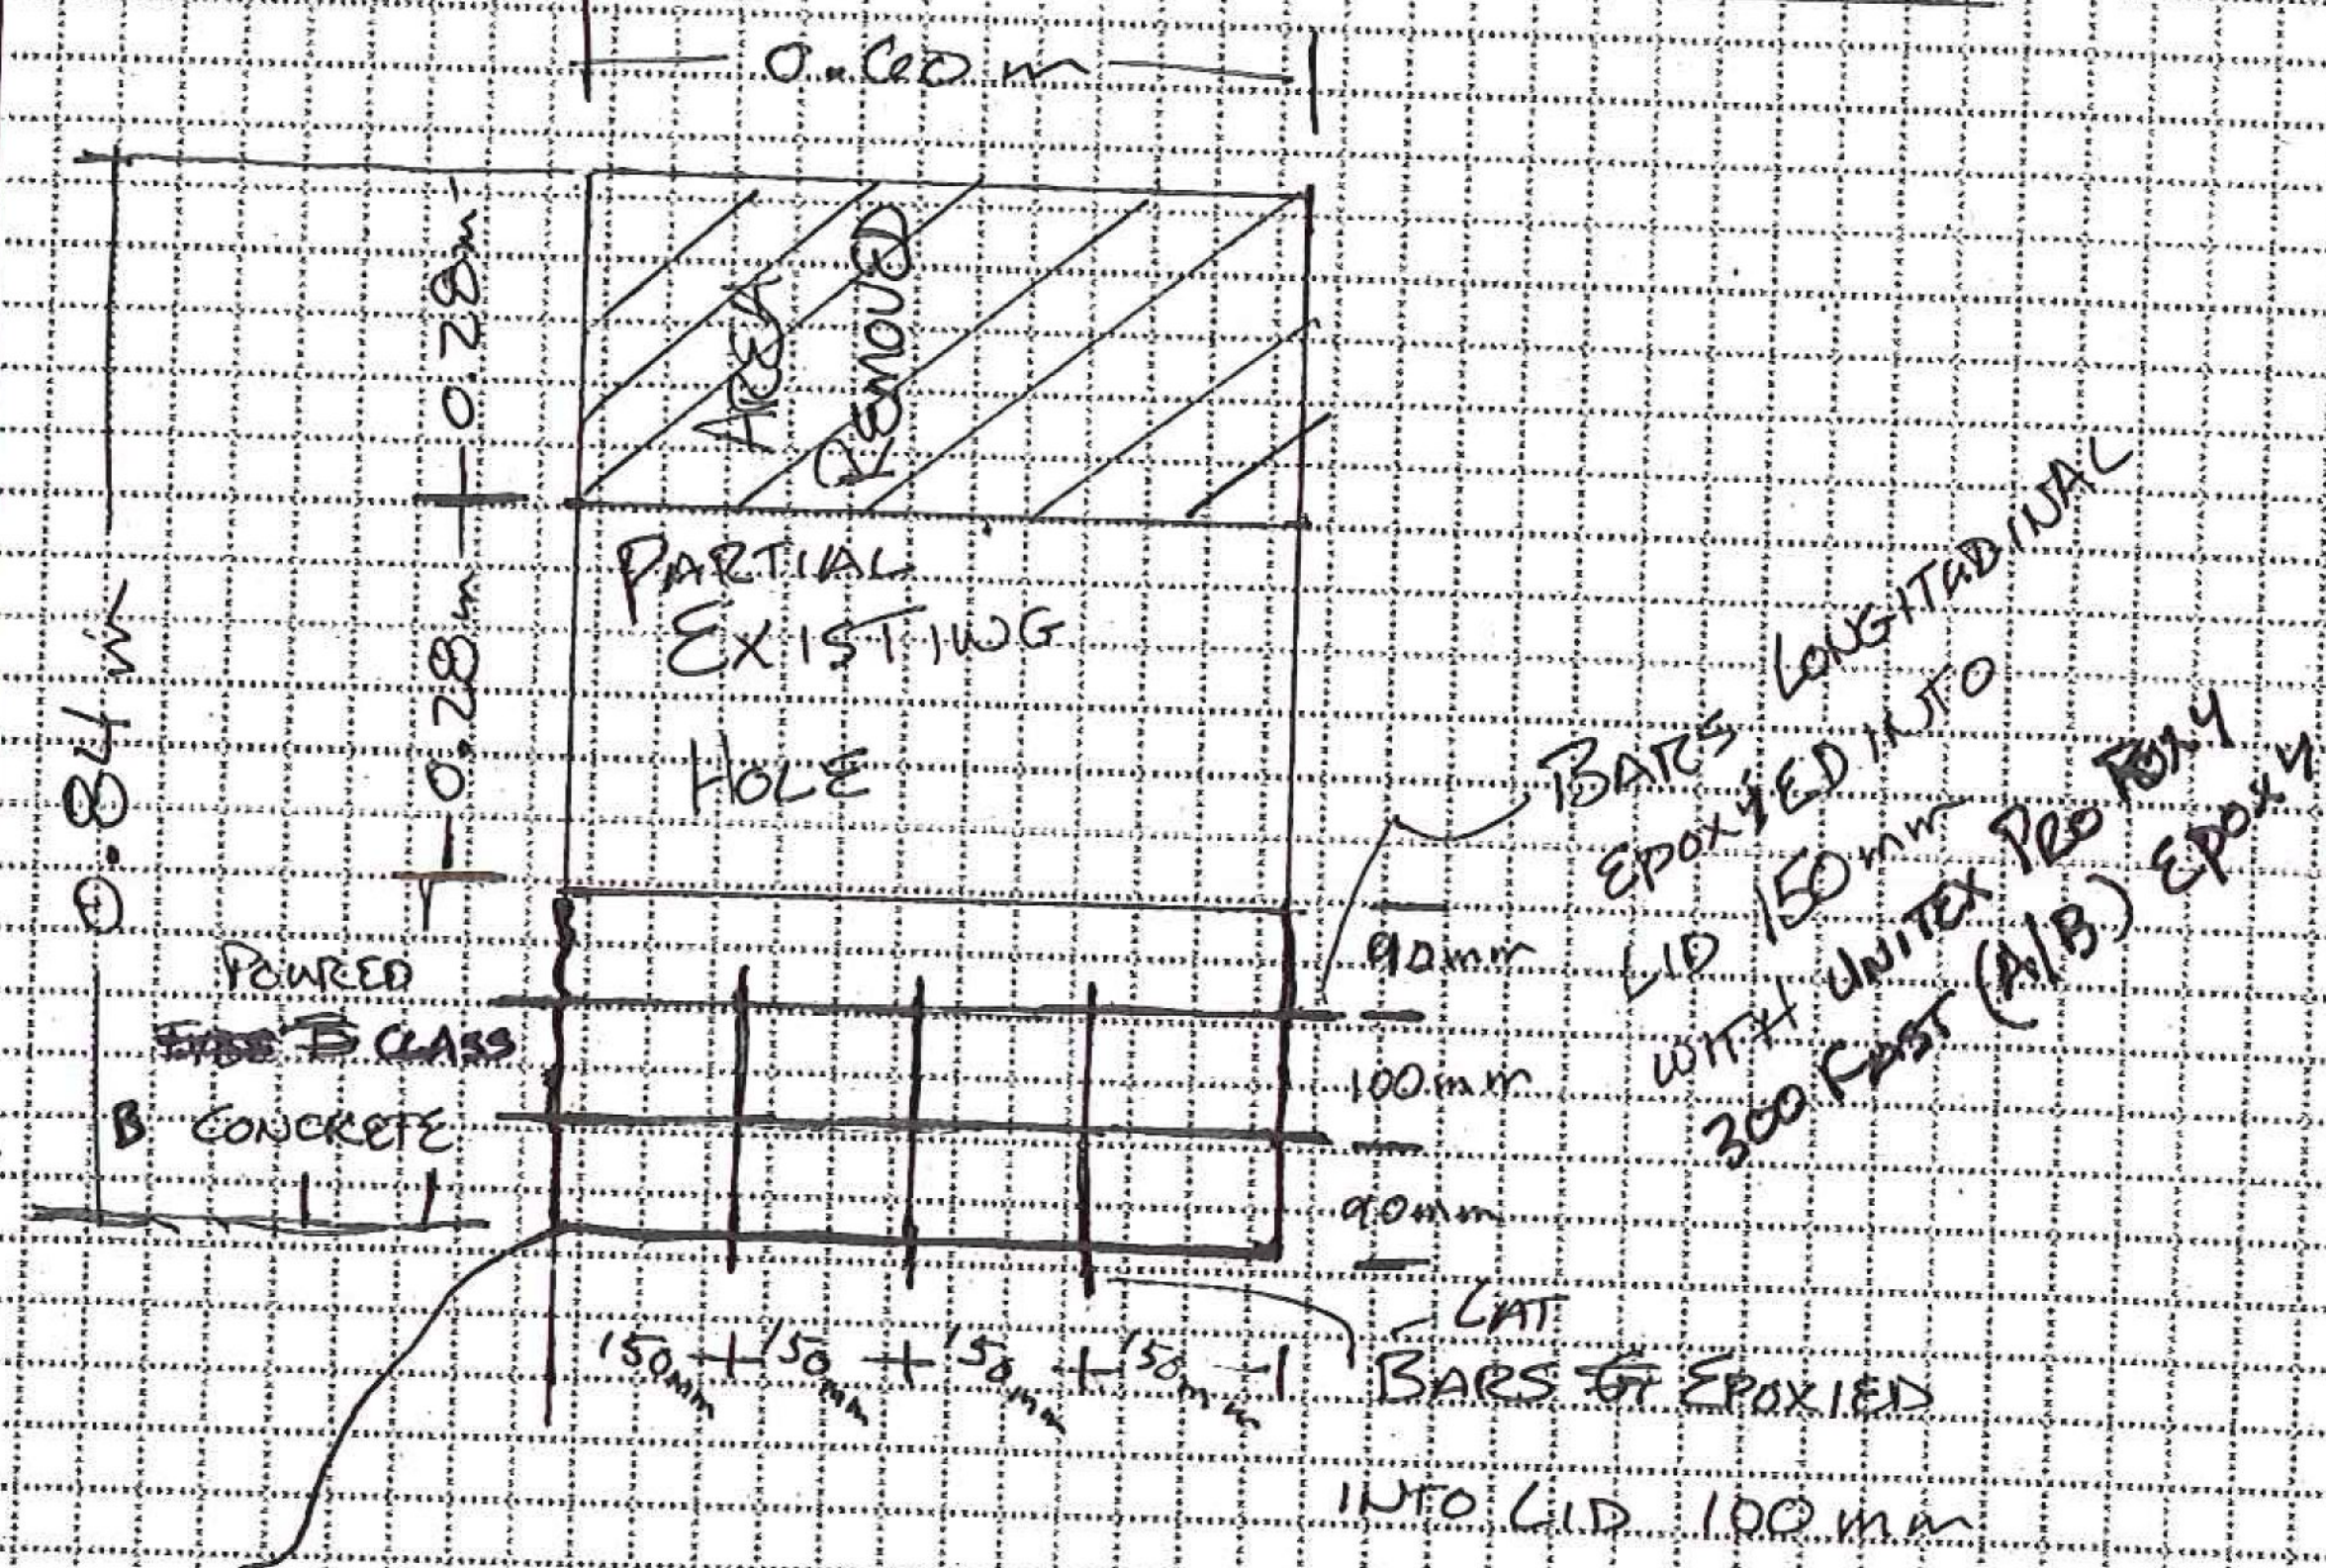

PLACED SILPRO (BONDING AGENT)

C-21 ALL ACRYLIC

- BARS - #13 REBAR EPOXY COATED