


8/18/2010
E:\2001\2007038_00_Bonnington Bypass\Bonnington Bypass\Centrect 54\Drawings\System 2 Outlet Cen2 08-18-10.dcn

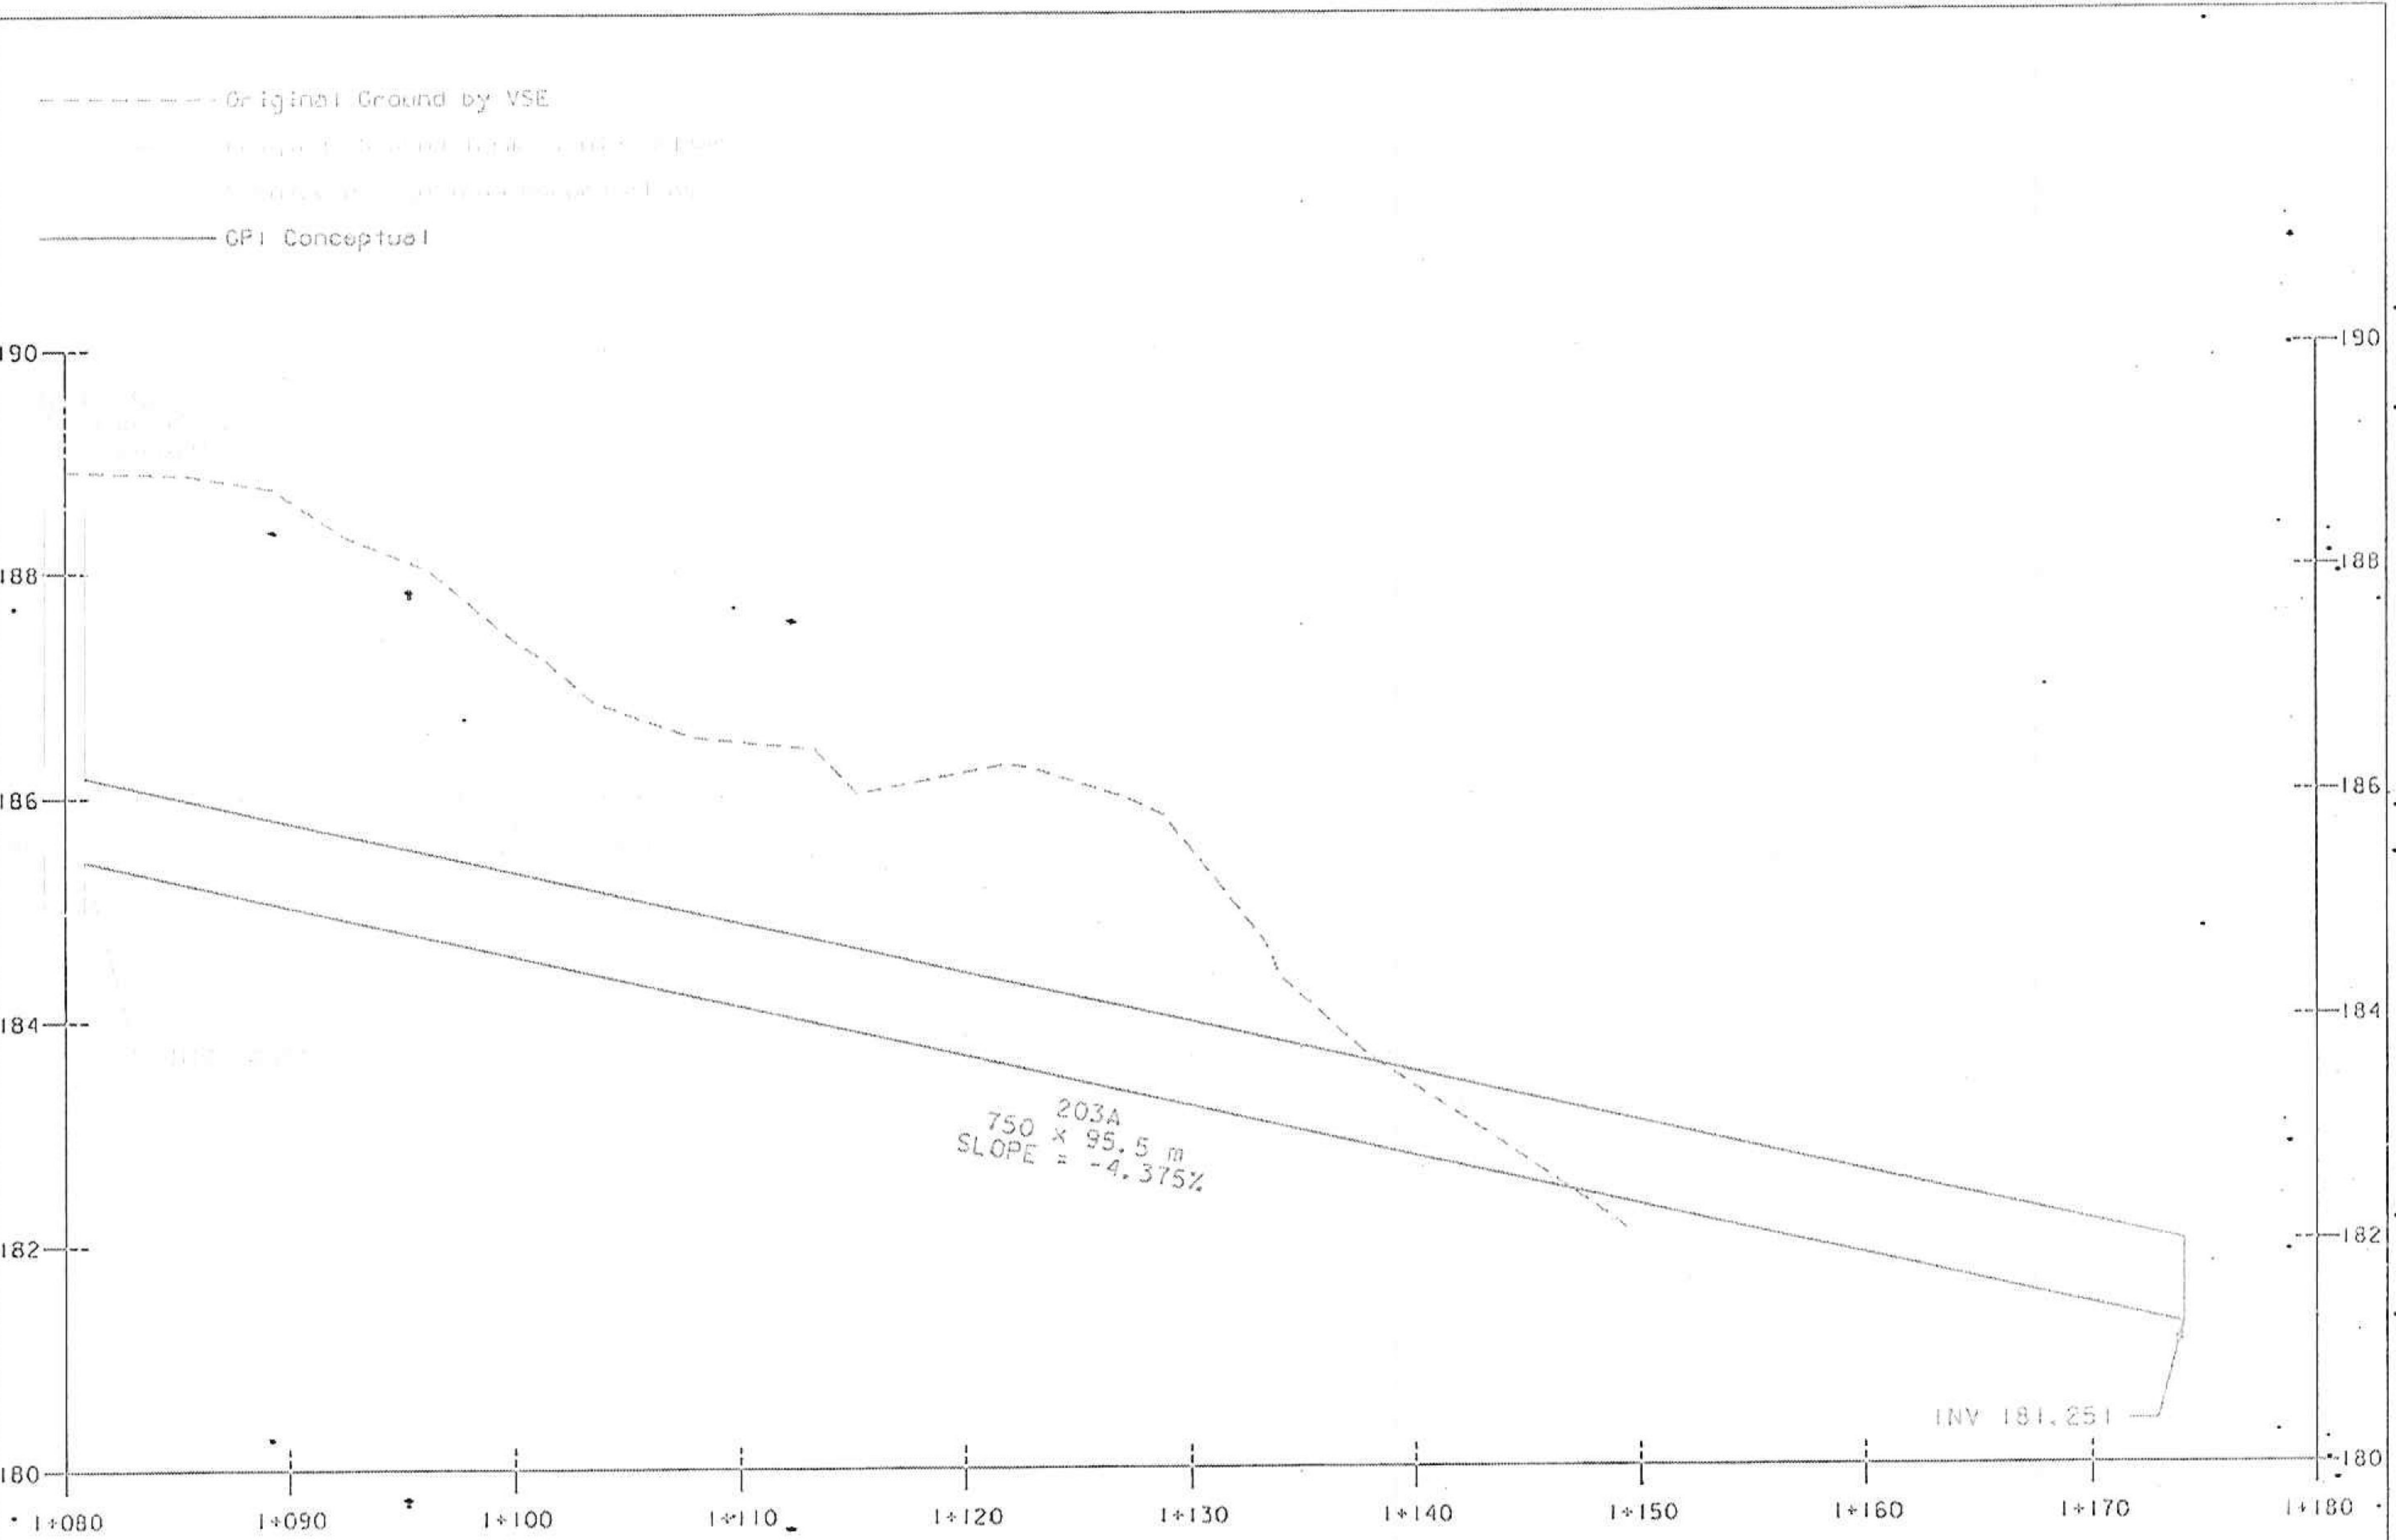

Conceptual System 2 Outlet 08-18-10 Alt 1

This profile is for conceptual purposes only. Linework was take from Stantec's Record Plans. GPI made conceptual modifications by eliminating DMH202 through Pipe 200, and tying pipe 203A to a 1.0 m offset from the SW corner of the easement.

Bonnington AC NH 019-11541
Conceptual System 2 Outlet Alt 1
August 18, 2010
Calculated by GPI
Scale 1:400

RECORD PLANS