


8/18/2010

E:\2007\200703\00 Bennington Bypass\Bennington Bypass\Contract 54\Drainage\System 2 Outlet\System 2 Outlet Con2 08-18-10.dwg

----- Original Ground by VSE

----- Proposed Ground by VSE

----- GPI Conceptual

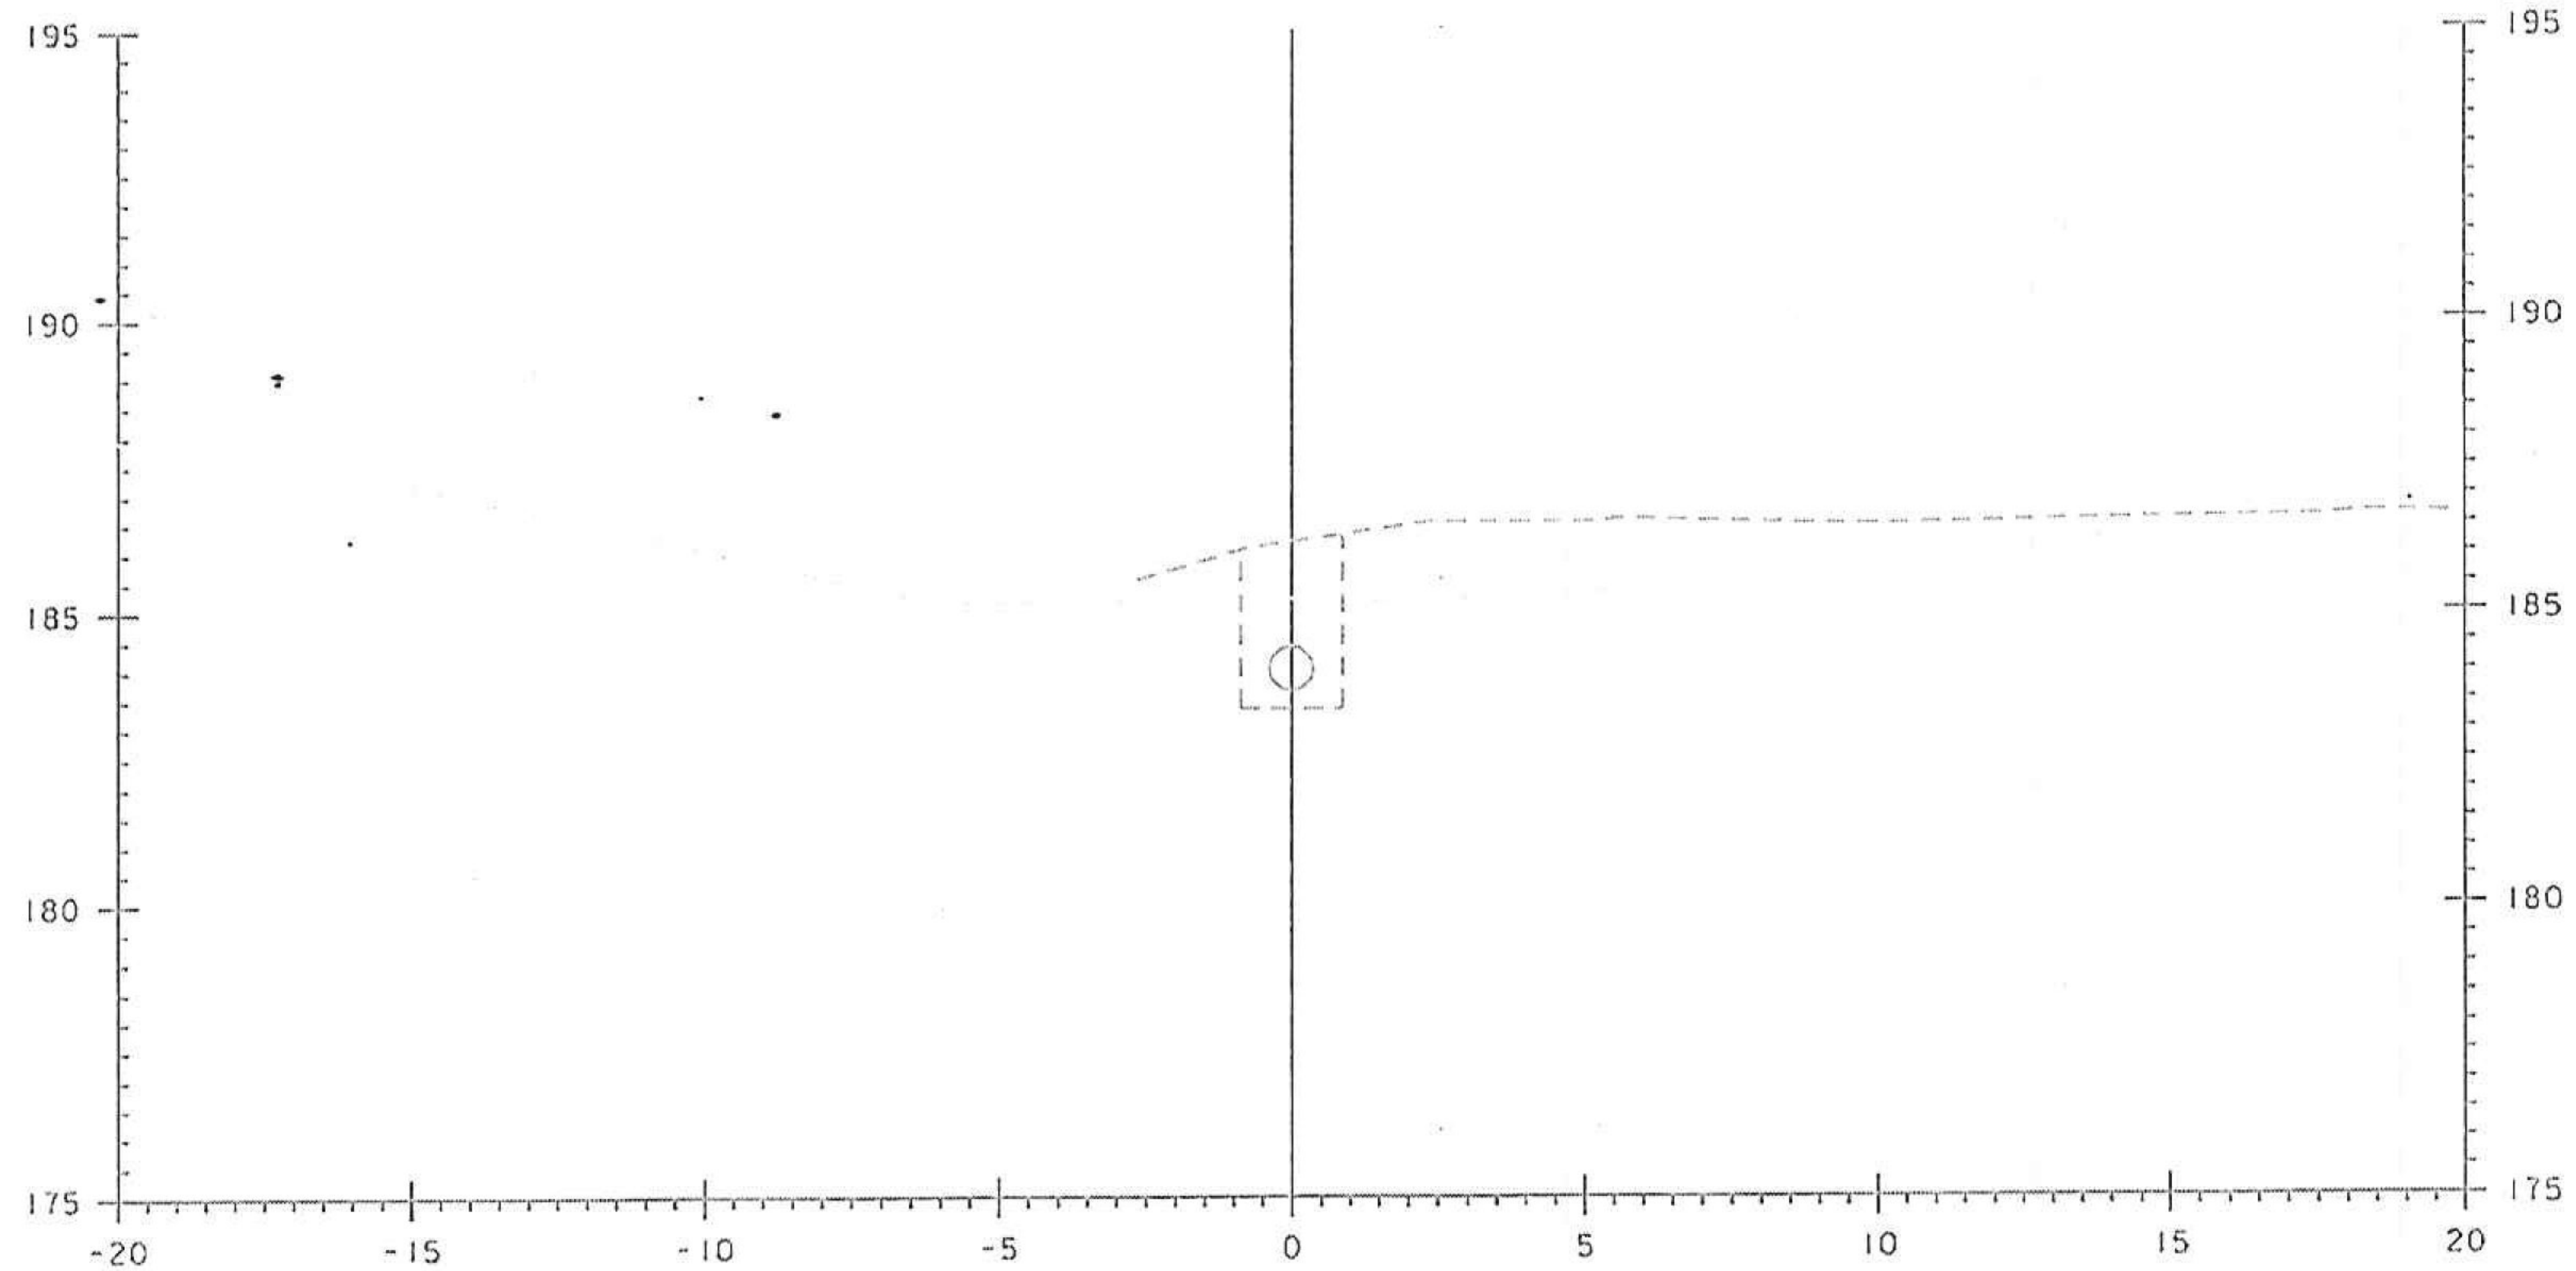

DRN 1+120.000

Cross Sections are for conceptual purposes only, based upon a conceptual profile developed by GPI. This conceptual profile was developed by taking linework from Stantec's Record Plans and making conceptual modifications by eliminating DMH202 through Pipe 200, and tying pipe 203A to a 1.0 m offset from the SW corner of the easement.

Bennington AC NH 019-1 (54)
Conceptual System 2 Outlet Alt 1
August 18, 2010
Scale 1:200

RECORD PLANS