



**PRCC DI 307 - 307
SB 10+065.0 LT.**

DP-08

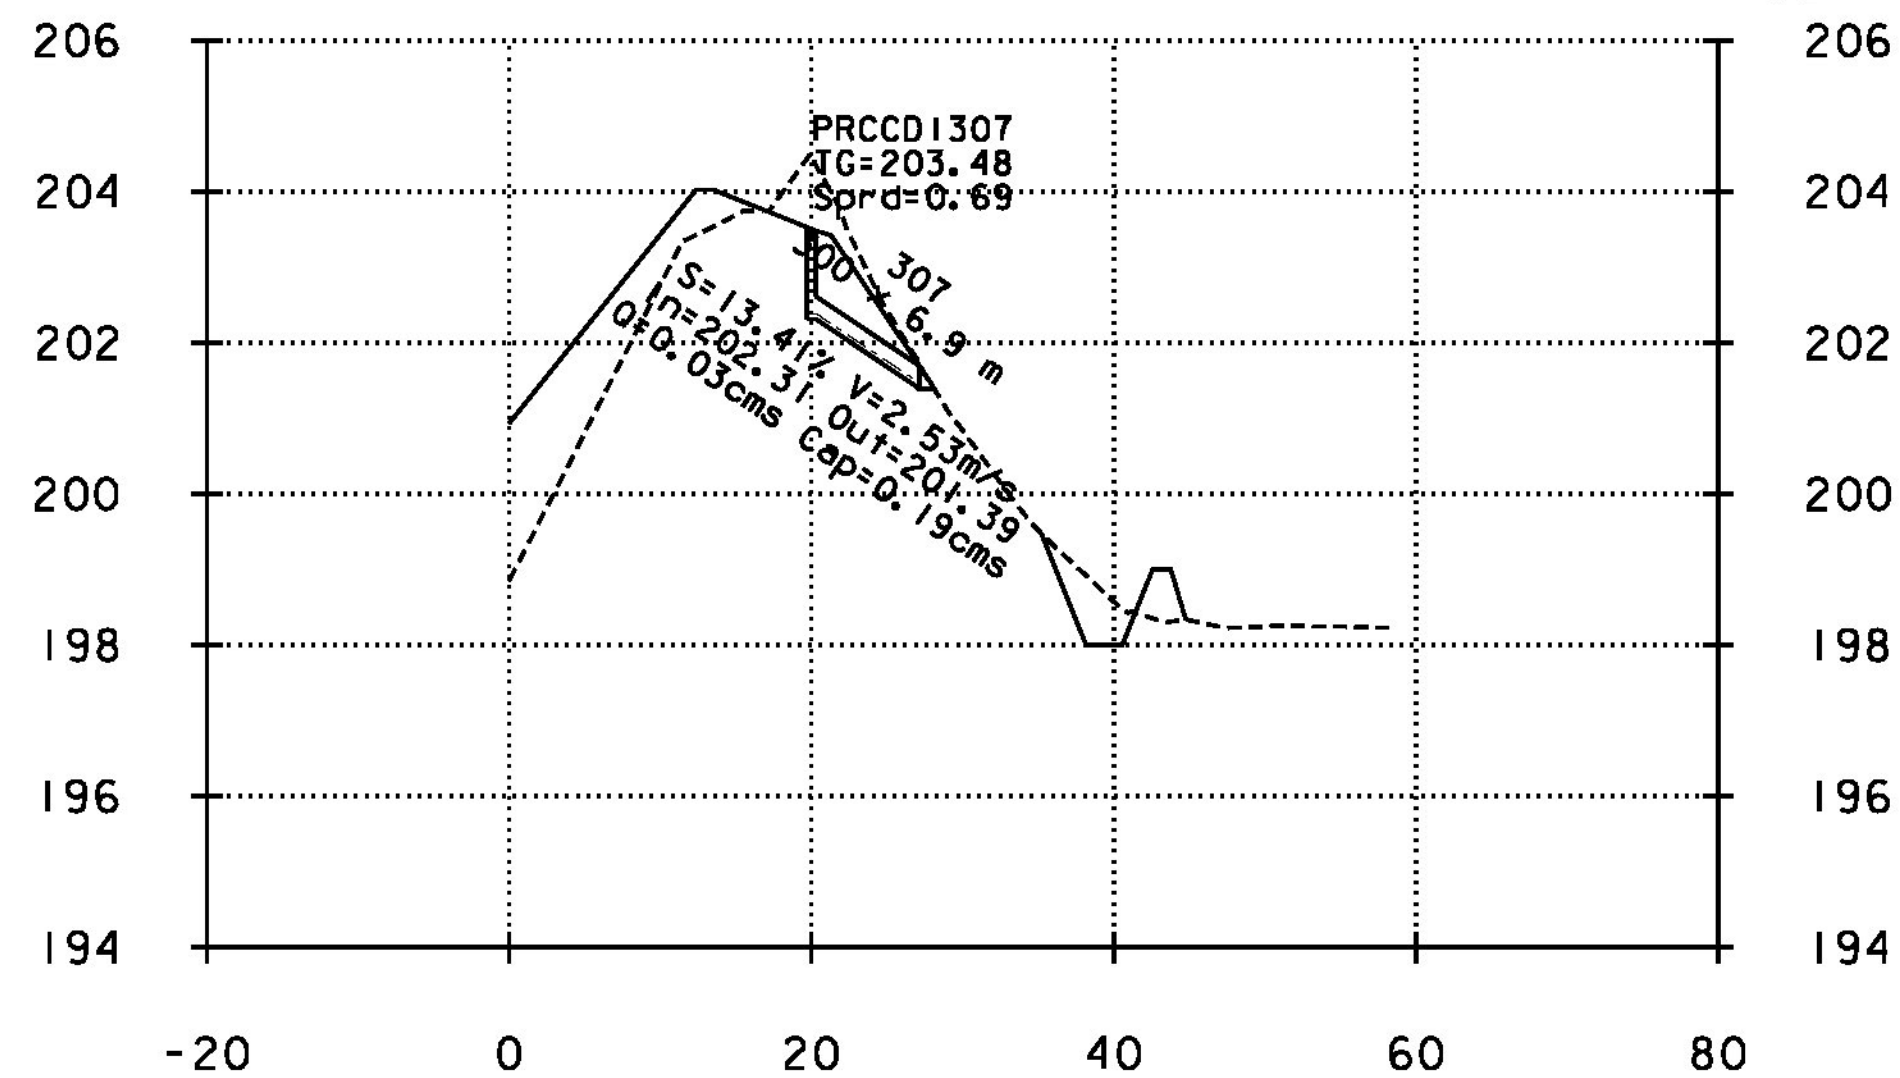


**PRCC DI 308 - 308
SB 9+990.0 LT.**

DP-08

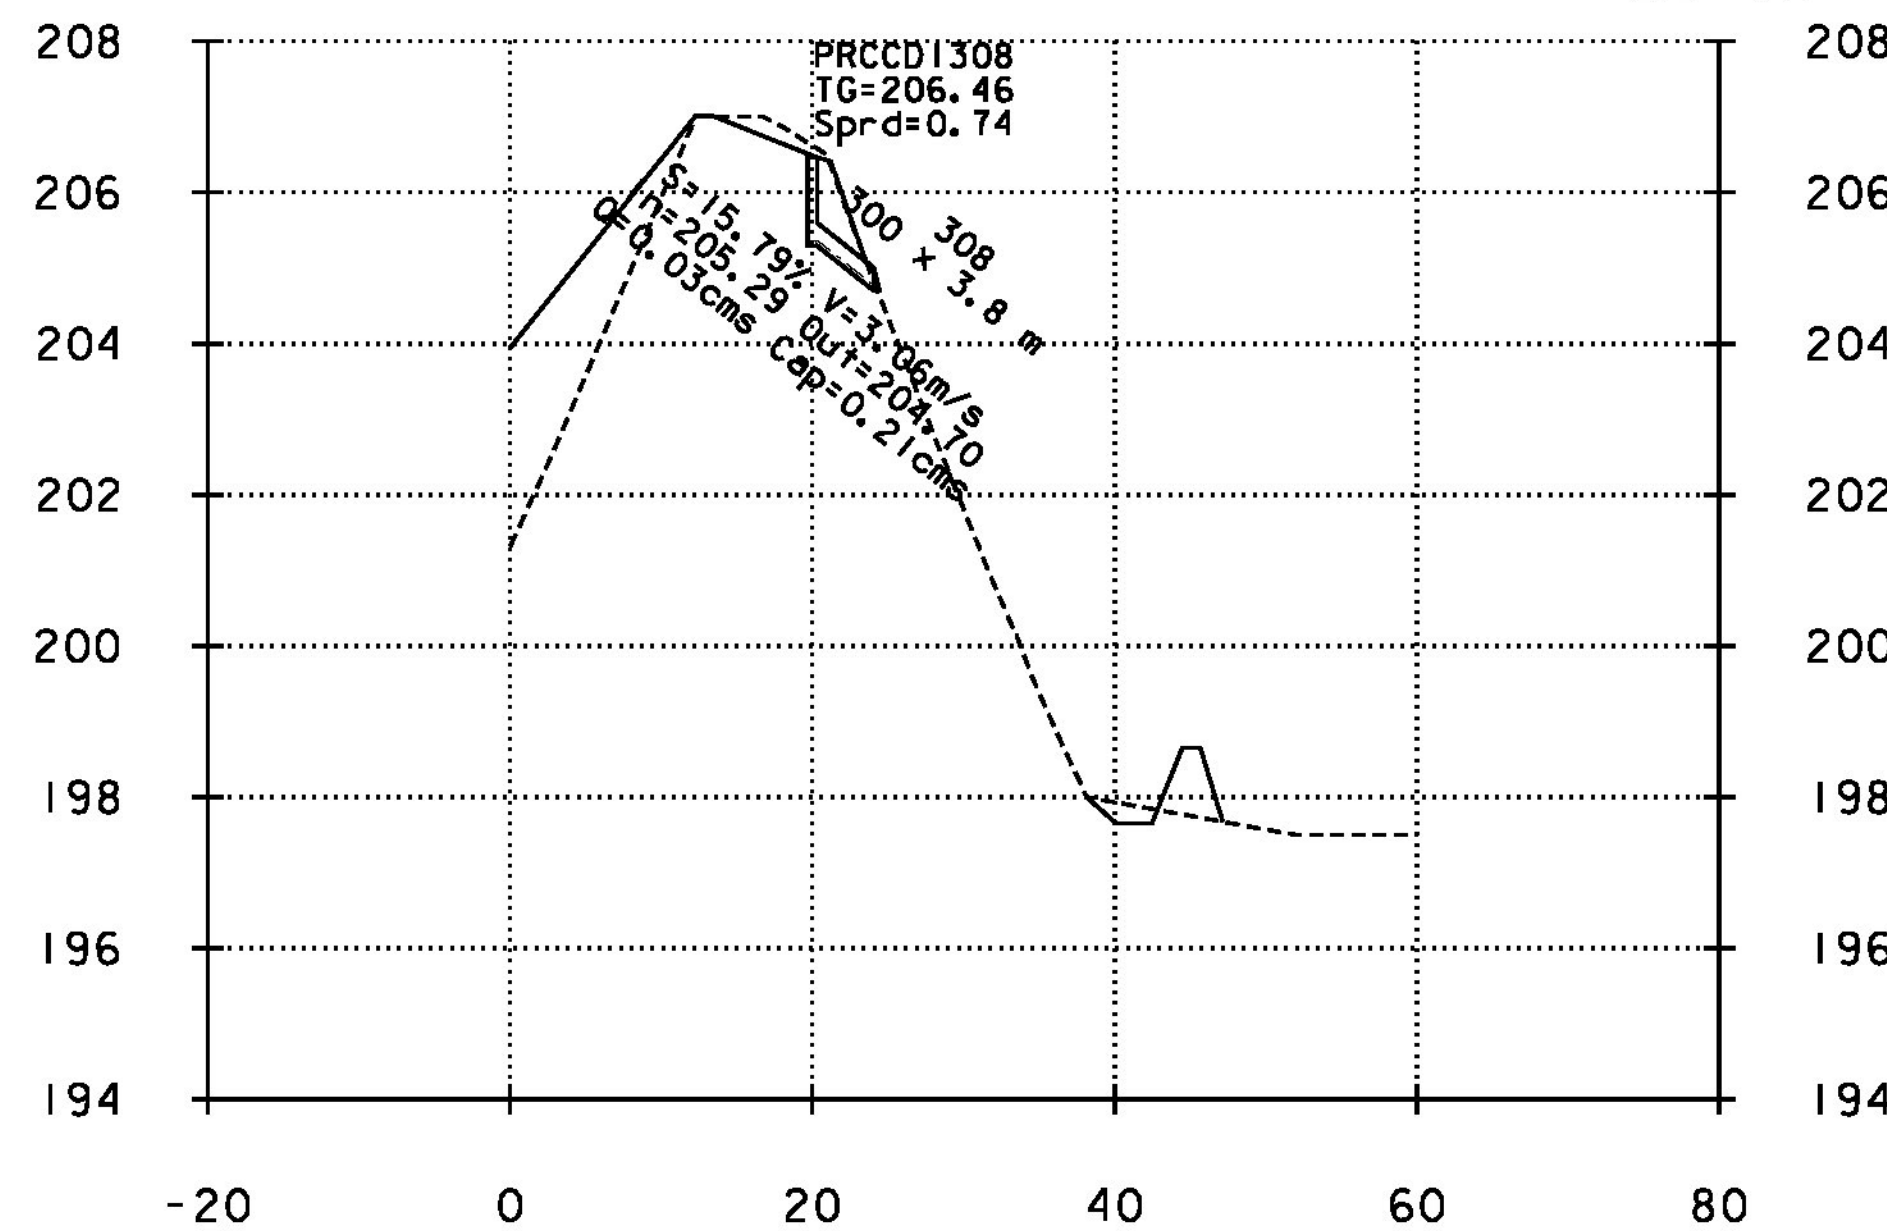


**315 - DI315
L 1+110.0 LT.-RT.**

DP-09

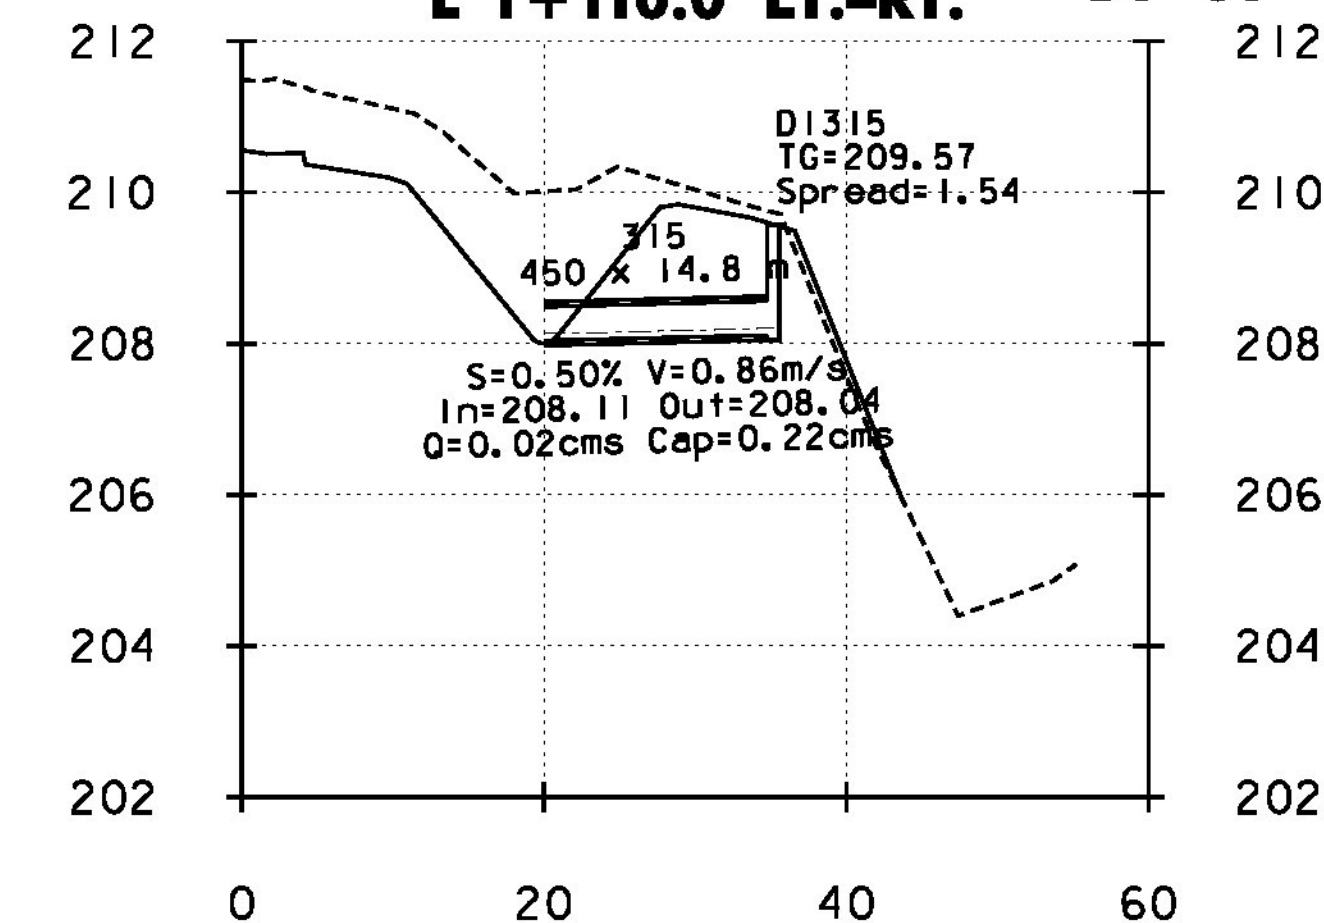


**PRCC DI 310 - 310
SB 9+840.0 LT.**

DP-09

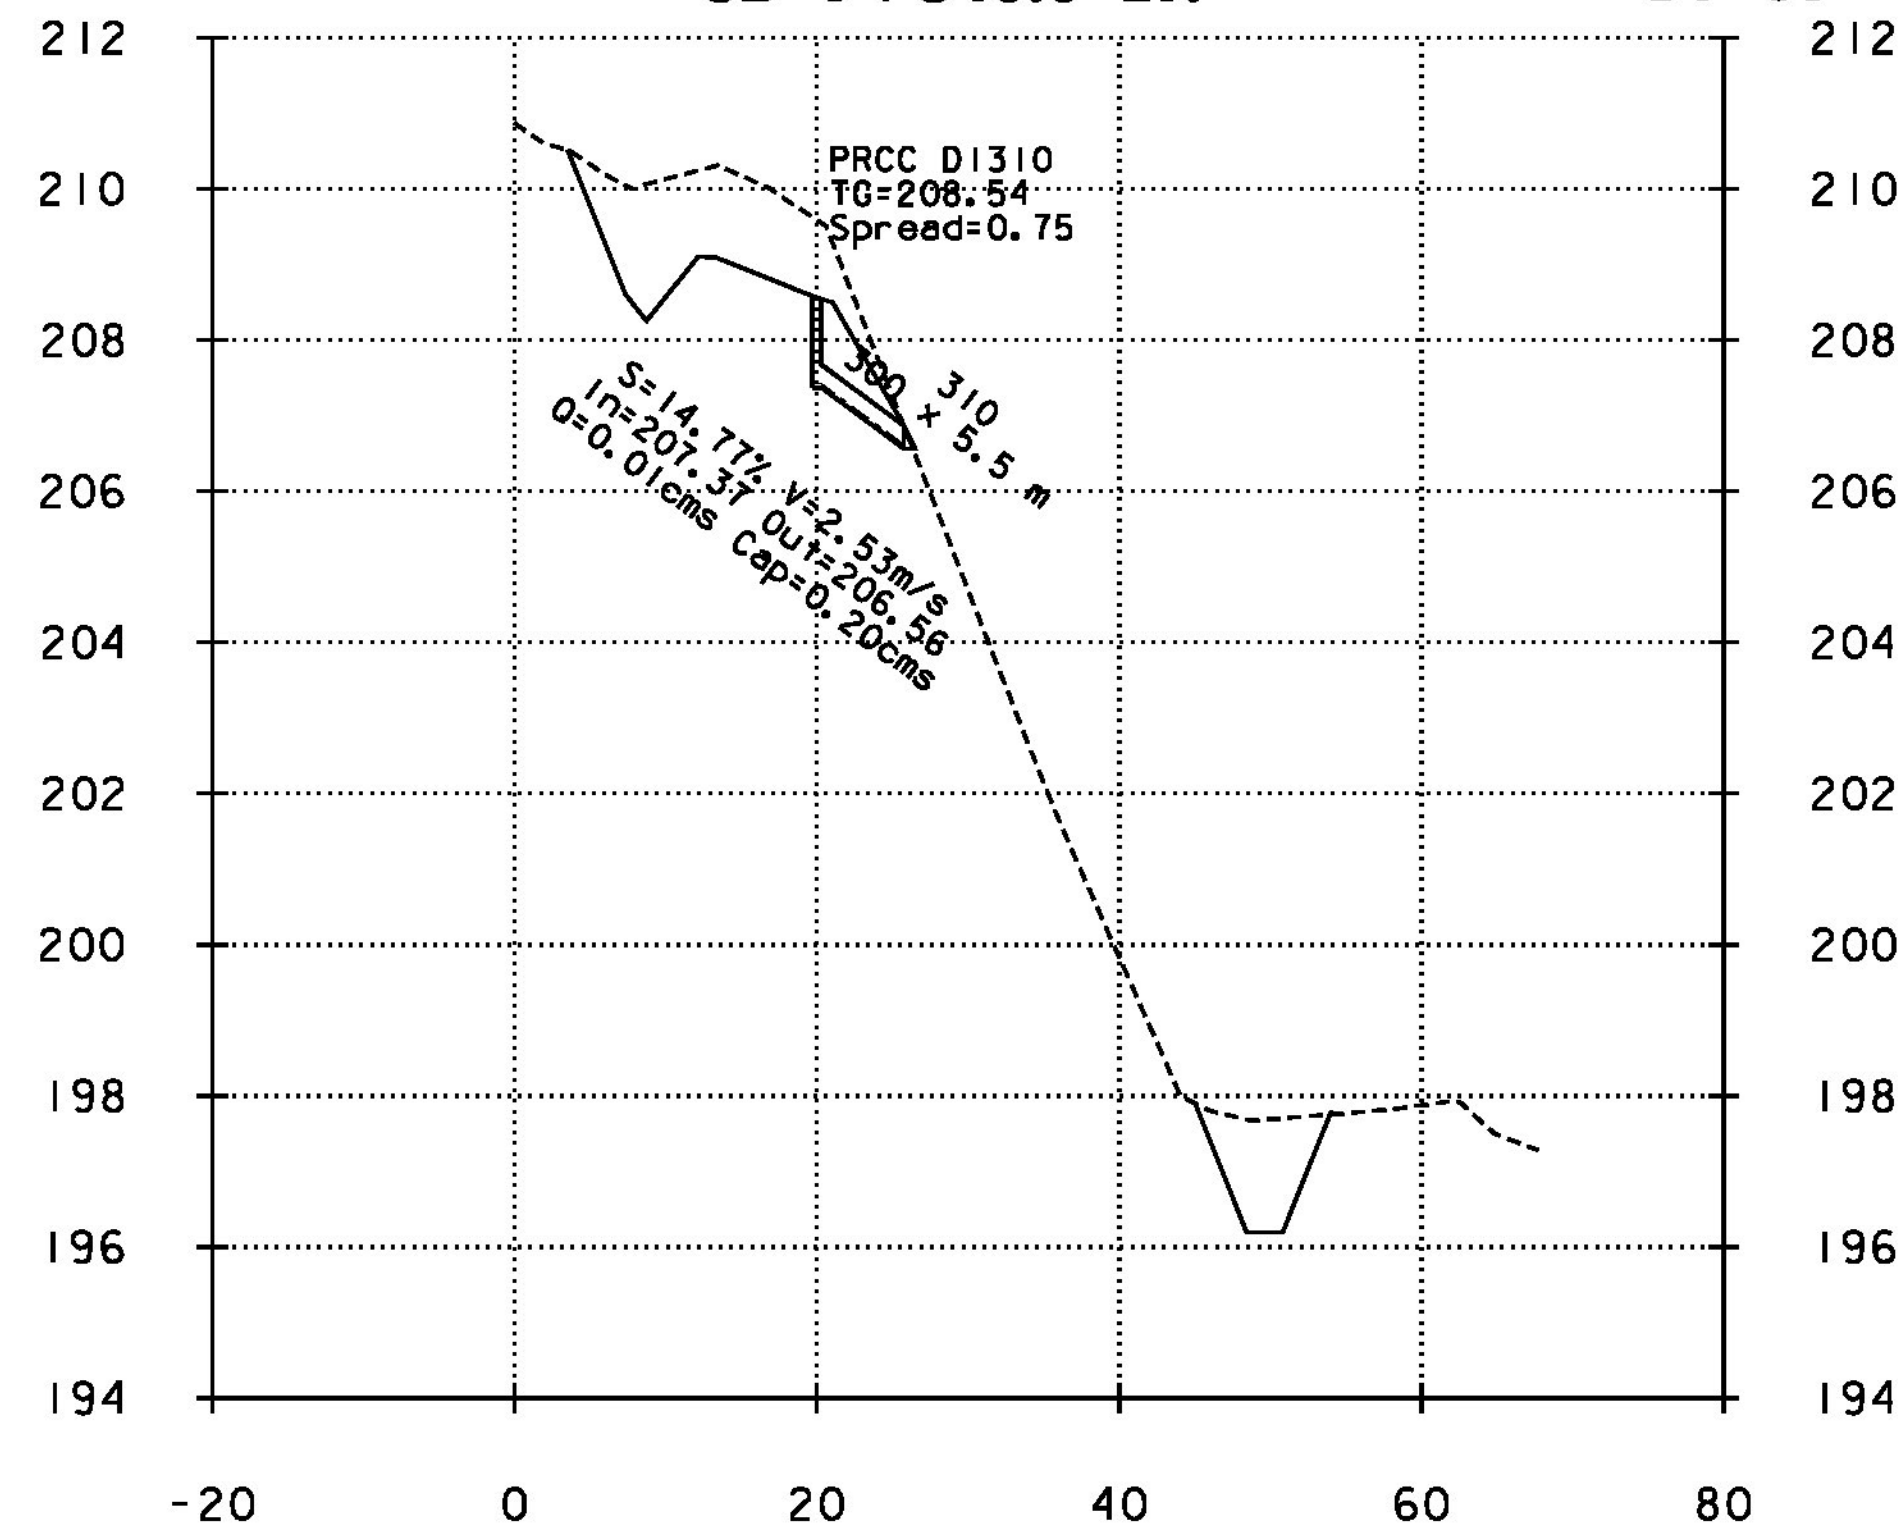



**DI 312 - 311
SB 9+765.0 RT. - SB 9+765.0 LT.**

DP-09

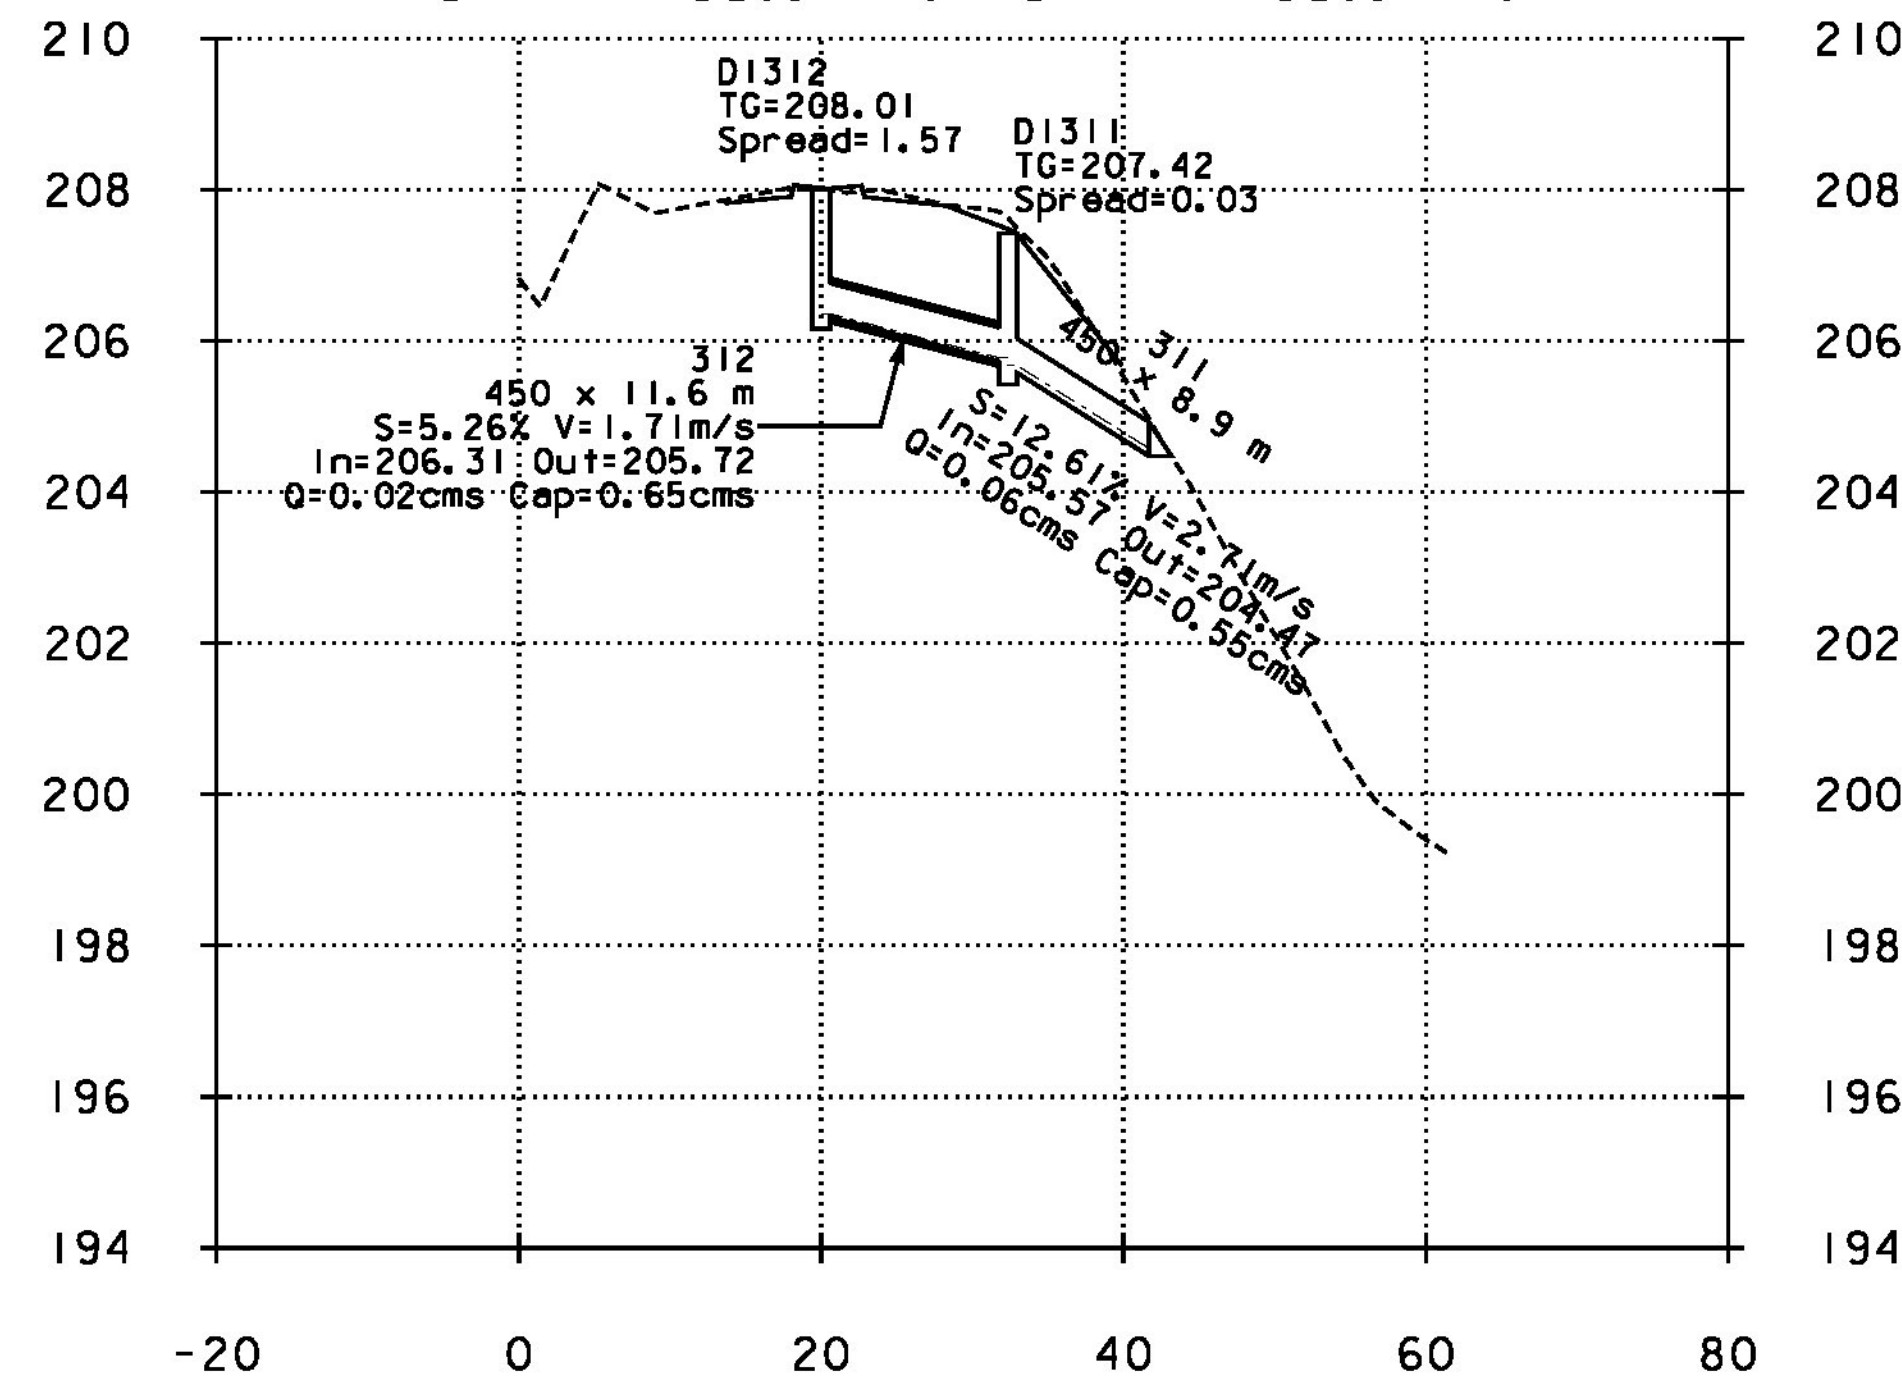

**316 - DI316
L 1+185.0 LT.-RT.**

DP-09

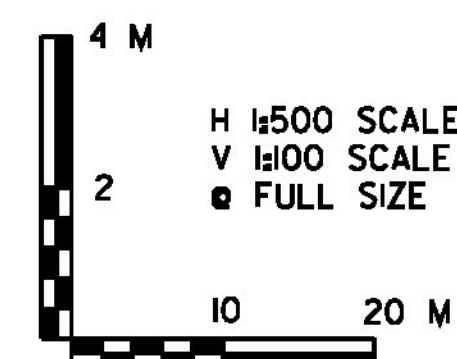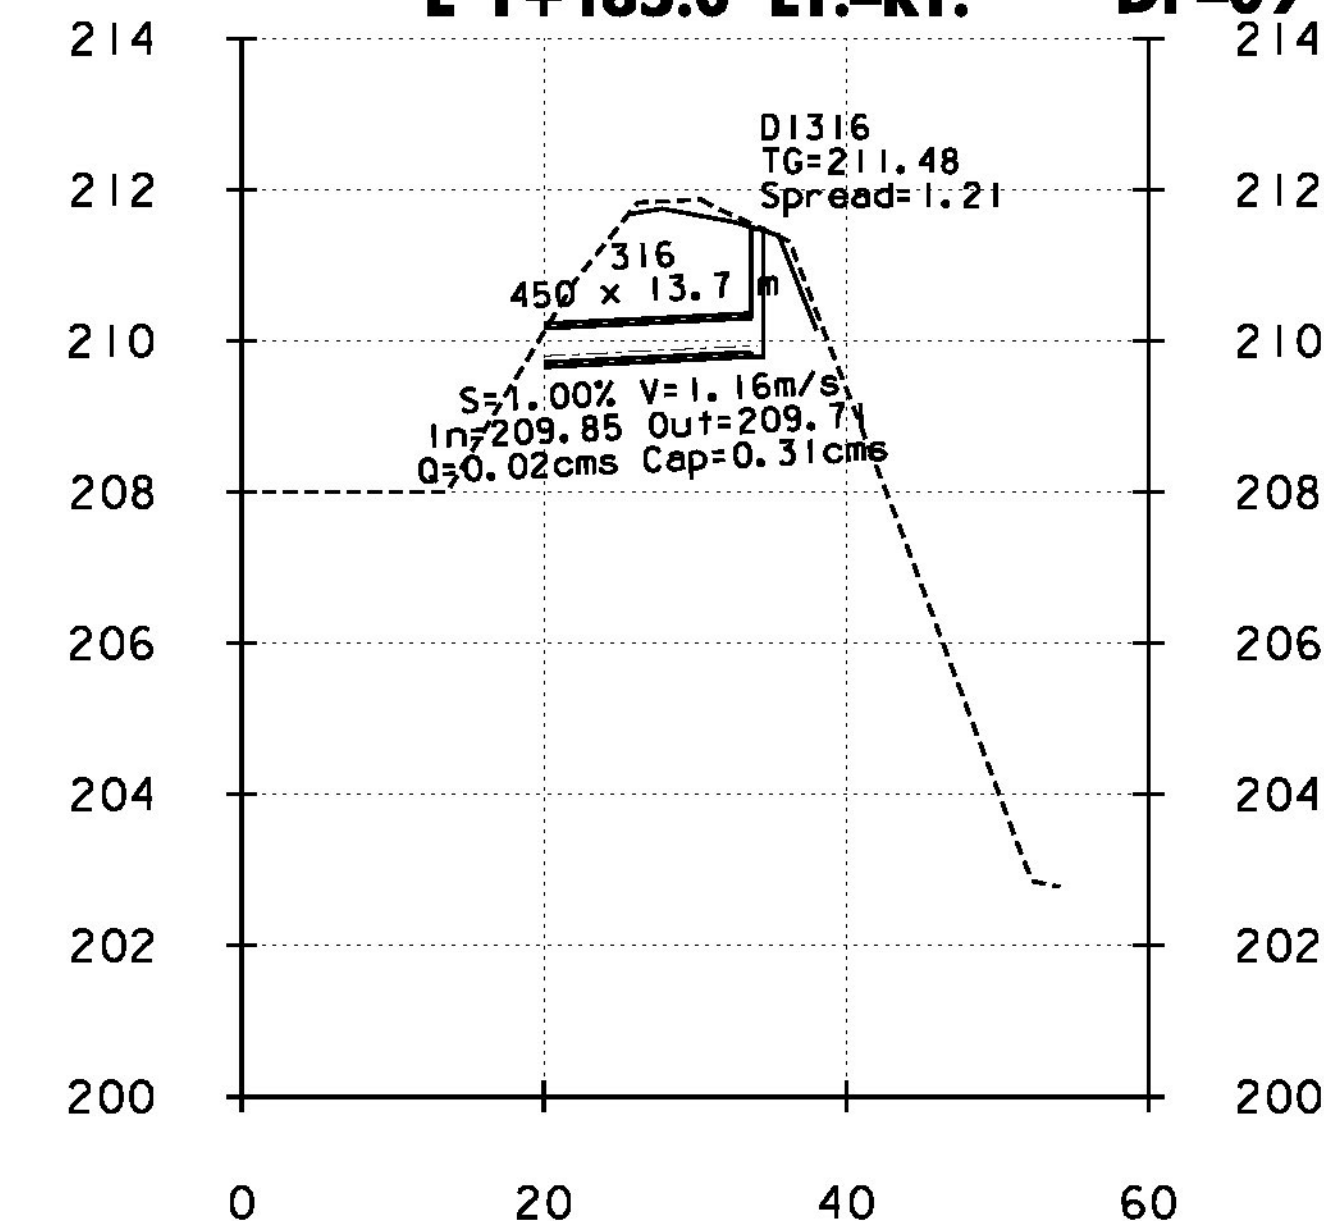

SYSTEM 3



PROJECT NAME:	BENNINGTON
PROJECT NUMBER:	NH 019-1(54)
FILE NAME:	...\\plot_files\zd307c4drn.pro.ptf
DESIGN SUPERVISOR:	GREG EDWARDS
DESIGNED BY:	MARC FOISY
DRAINAGE PROFILE SHEET	DPRO-08
PLOT DATE:	1/26/2010
DRAWN BY:	STANTEC
CHECKED BY:	GARY SANTY
SHEET	146 OF 468

1/26/2010 4:48:06 PM v:\953\active\953002\transportation\drainage\contract\4\plot_files\zd307c4drn.pro.ptf