

GEOTEXTILE FOR SILT FENCE
 STA. L 1+473.6, 10.8m RT. - STA. L 1+280.0, 10.0m RT.

TEMPORARY STONE CHECK DAM, TYPE I
 STA. WB 9+745.1 - STA. WB 9+880.0, RT.
 STA. EB 9+587.0 - STA. EB 9+820.0, RT.
 STA. EB 9+720.0 - STA. EB 9+820.0, LT.

INLET PROTECTION DEVICE, TYPE I


STA.	DESCRIPTION
WB 9+650.9, 43.5m LT.	(EXCAVATED)
WB 9+650.9, 13.9m LT.	(EXCAVATED)
WB 9+738.6, 12.8m LT.	(EXCAVATED)
WB 9+879.1, 9.4m RT.	(EXCAVATED)
WB 9+740.1, 16.0m RT.	(FILTER FABRIC)

VEHICLE TRACKING PAD
 STA. EB 9+641.0, LT

AREA NUMBER	SEEDING WINTER RYE & HAY MULCHING	EROSION MATTING AREAS
1	2014.6 SM	
2	1259.7 SM	
3		703.0 SM
4	1485.6 SM	684.4 SM
5		
6	1722.6 SM	
7	1615.4 SM	
8		628.3 SM
9		495.5 SM

ONLY REQUIRED FOR OPTIONAL WASTE AREA

AREA ID	AREA	DESCRIPTIONS
A	1846.6 SM	TEMPORARY EROSION MATTING
B	3168.4 SM	SEED, WINTER RYE AND HAY MULCH

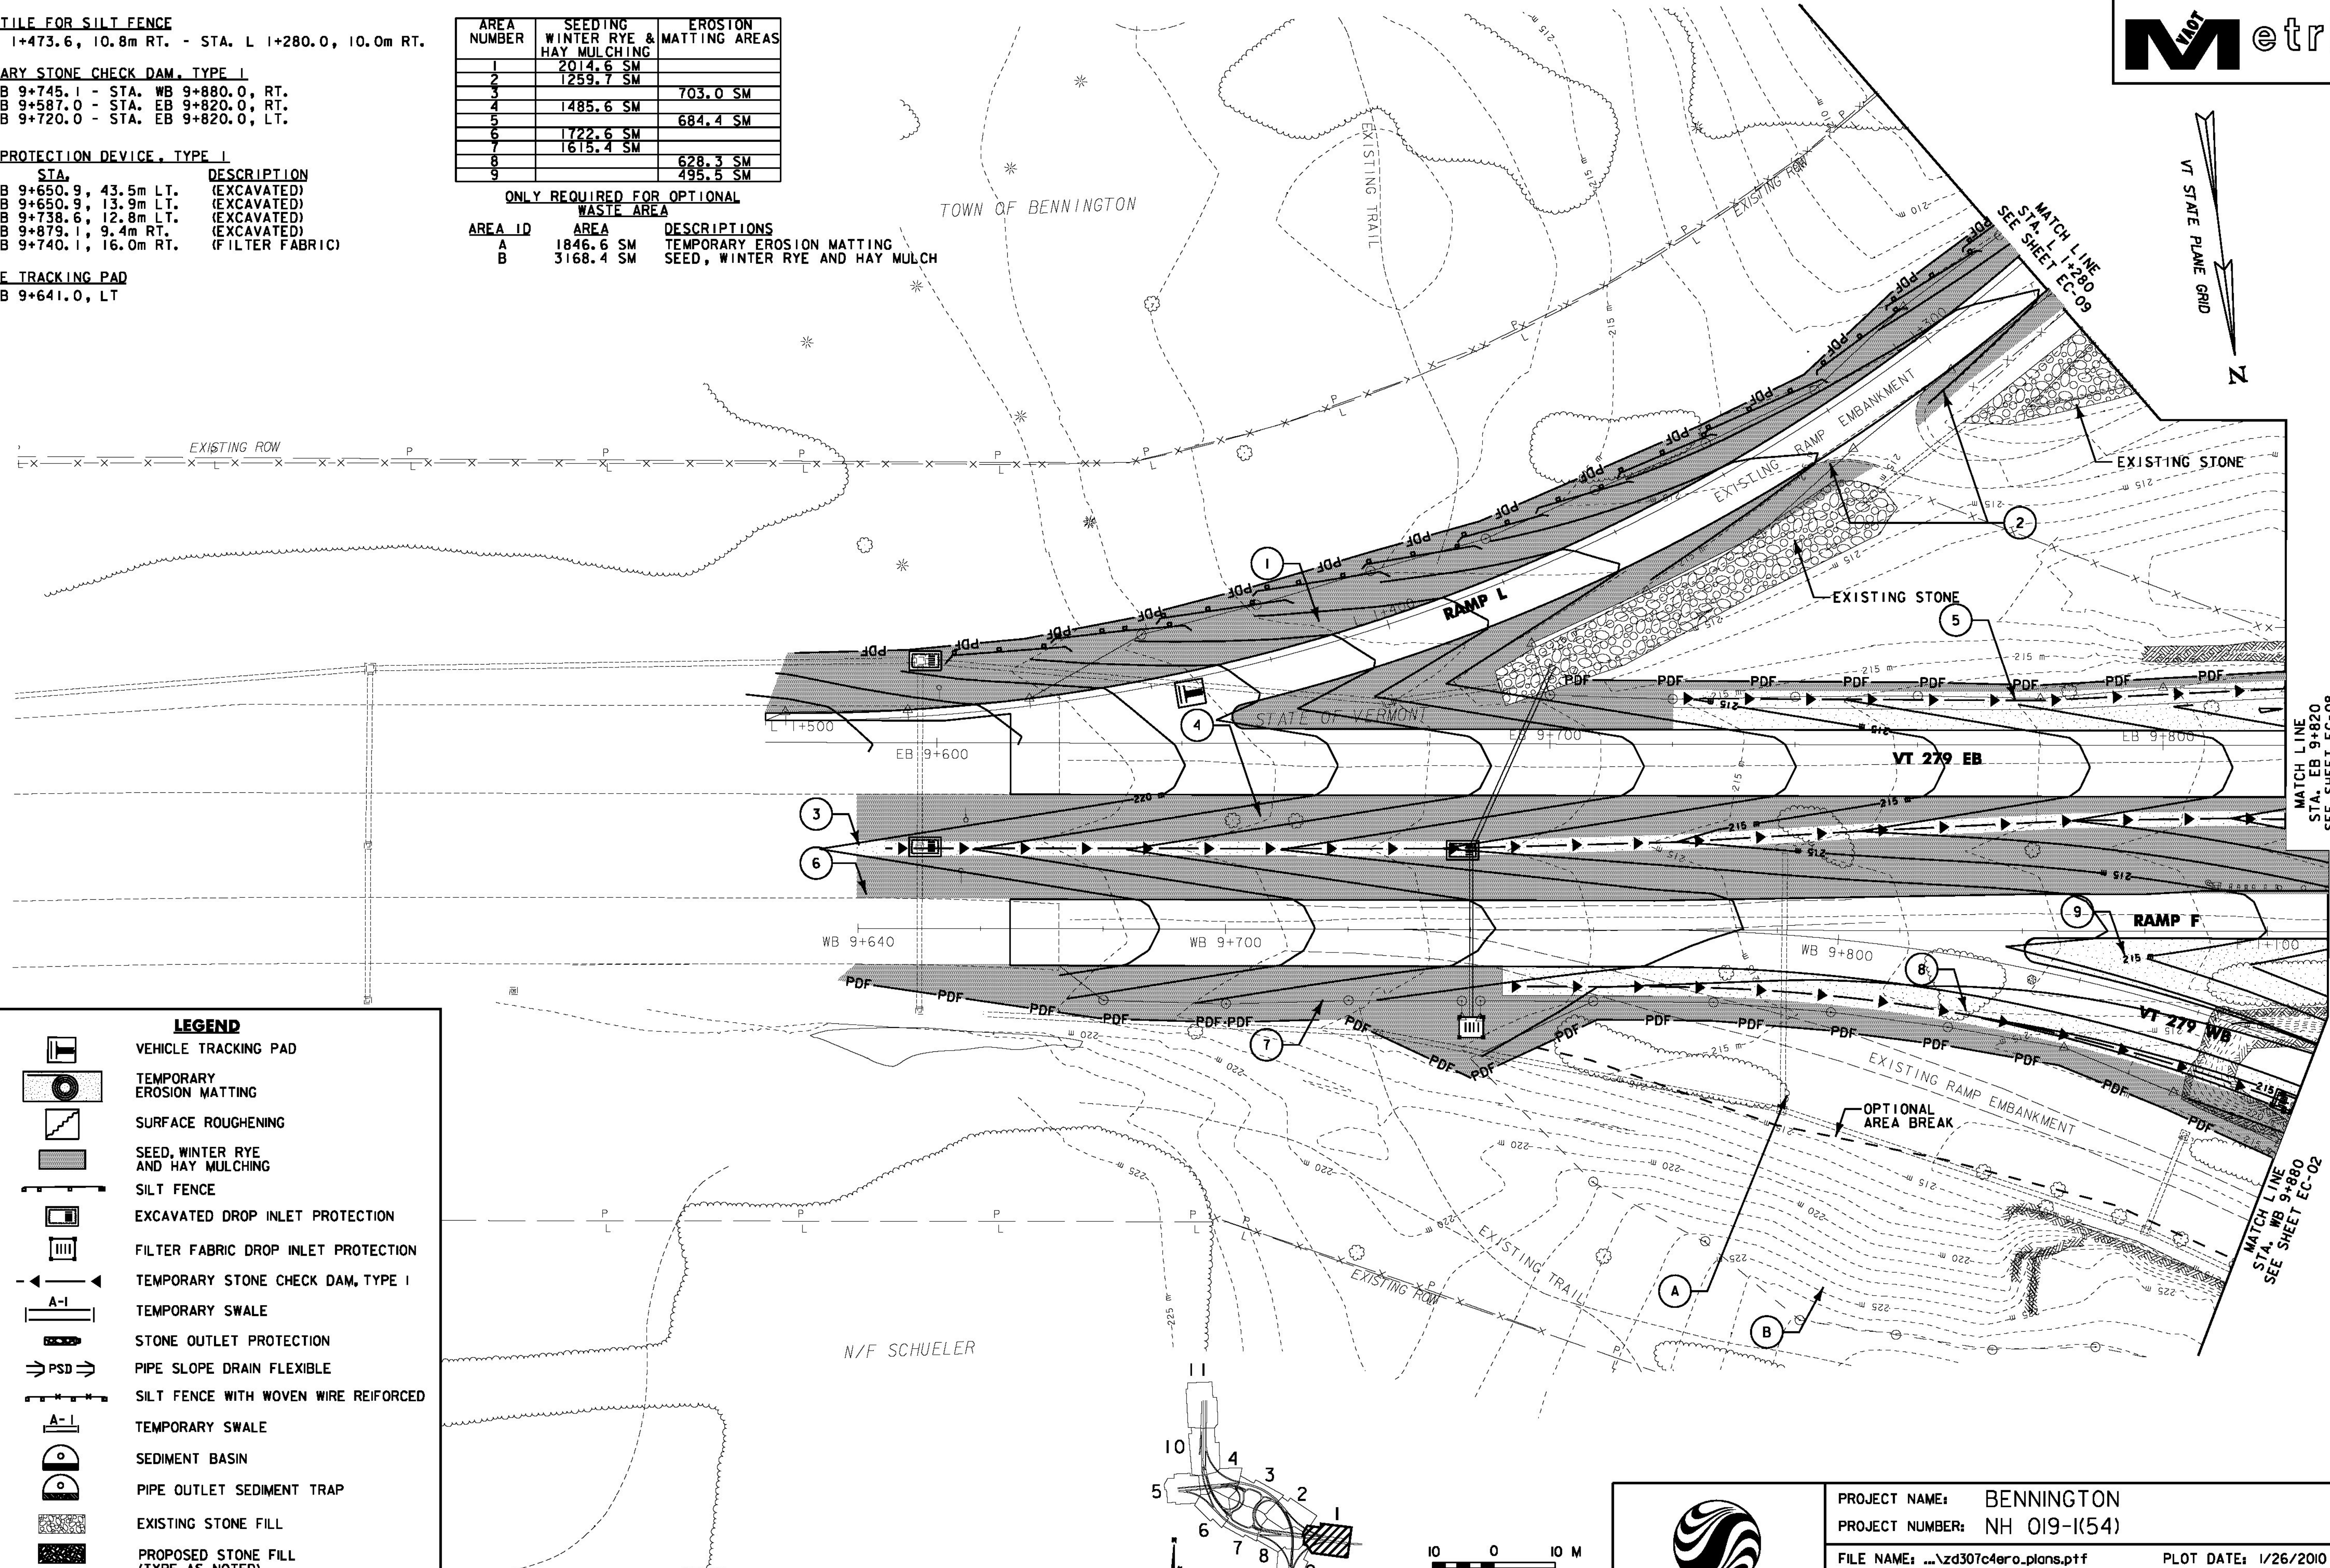

LEGEND

- VEHICLE TRACKING PAD
- TEMPORARY EROSION MATTING
- SURFACE ROUGHENING
- SEED, WINTER RYE AND HAY MULCHING
- SILT FENCE
- EXCAVATED DROP INLET PROTECTION
- FILTER FABRIC DROP INLET PROTECTION
- TEMPORARY STONE CHECK DAM, TYPE I
- TEMPORARY SWALE
- STONE OUTLET PROTECTION
- PIPE SLOPE DRAIN FLEXIBLE
- SILT FENCE WITH WOVEN WIRE REINFORCED
- TEMPORARY SWALE
- SEDIMENT BASIN
- PIPE OUTLET SEDIMENT TRAP
- EXISTING STONE FILL
- PROPOSED STONE FILL (TYPE AS NOTED)

NOTE:
 PROPOSED CONTOURS DO NOT IDENTIFY SLOPE ROUNDINGS AS SHOWN ON CROSS SECTIONS AND THEREFORE MAY NOT MATCH CONSTRUCTION LIMITS.



PROJECT NAME: BENNINGTON
PROJECT NUMBER: NH 019-1(54)
FILE NAME: ...zd307c4ero.plans.ptf
DESIGN SUPERVISOR: GREG EDWARDS
DESIGNED BY: MARC FOISY
EROSION CONTROL PLANS EC-01

PLOT DATE: 1/26/2010
DRAWN BY: STANTEC
CHECKED BY: GARY SANTY
SHEET 150 OF 468

1/26/2010 4:55:56 PM v:\953\active\9531002\transportation\bennington\ec\1-26-10\ec-01-plans.ppt