

GEOTEXTILE FOR SILT FENCE

STA. EB 10+780.0, 13.9m LT. - STA. EB 10+646.5, 6.7m RT.
 STA. EB 10+780.0, 5.3m RT. - STA. EB 10+679.4, 13.2m LT.
 STA. SB 10+680.0, 2.4m LT. - STA. SB 10+764.4, 5.2m LT.
 STA. G 1+723.3, 2.5m RT. - STA. G 1+885.3, 6.9m RT.





TEMPORARY STONE CHECK DAM, TYPE I

STA. G 1+719.9 - STA. G 1+894.4, RT.
 STA. SB 10+700.1, RT. - STA. EB 10+490.0, RT.
 STA. SB 10+755.1, RT. - STA. EB 10+500.0, RT.

INLET PROTECTION DEVICE, TYPE I

STA.	DESCRIPTION
STA. G 1+840.2, 6.6m LT.	(FILTER FABRIC)
STA. R 1+140.0, 6.3m LT.	(FILTER FABRIC)

AREA NUMBER	SEEDING WINTER RYE & HAY MULCHING	EROSTON MATTING AREAS
46		477.3 SM
47	629.5 SM	
48	6010.7 SM	
49	1581.1 SM	
50	1532.9 SM	
51	3378.1 SM	
52		1208.2 SM

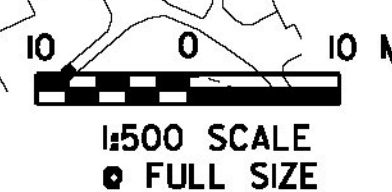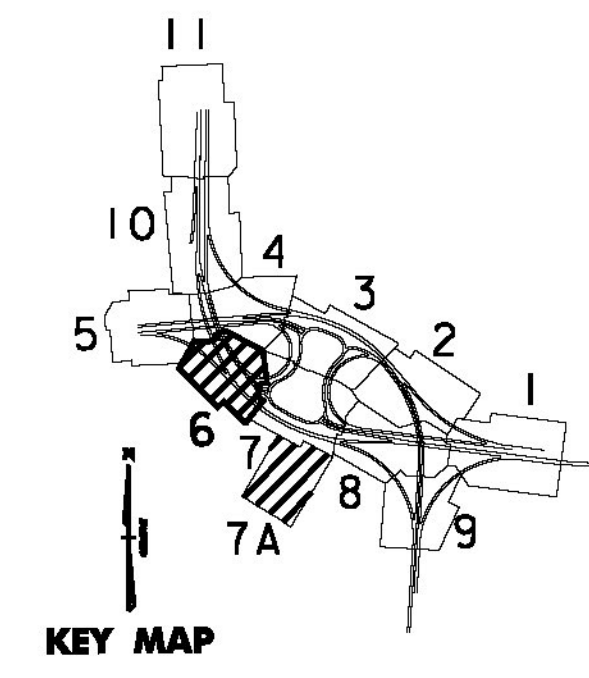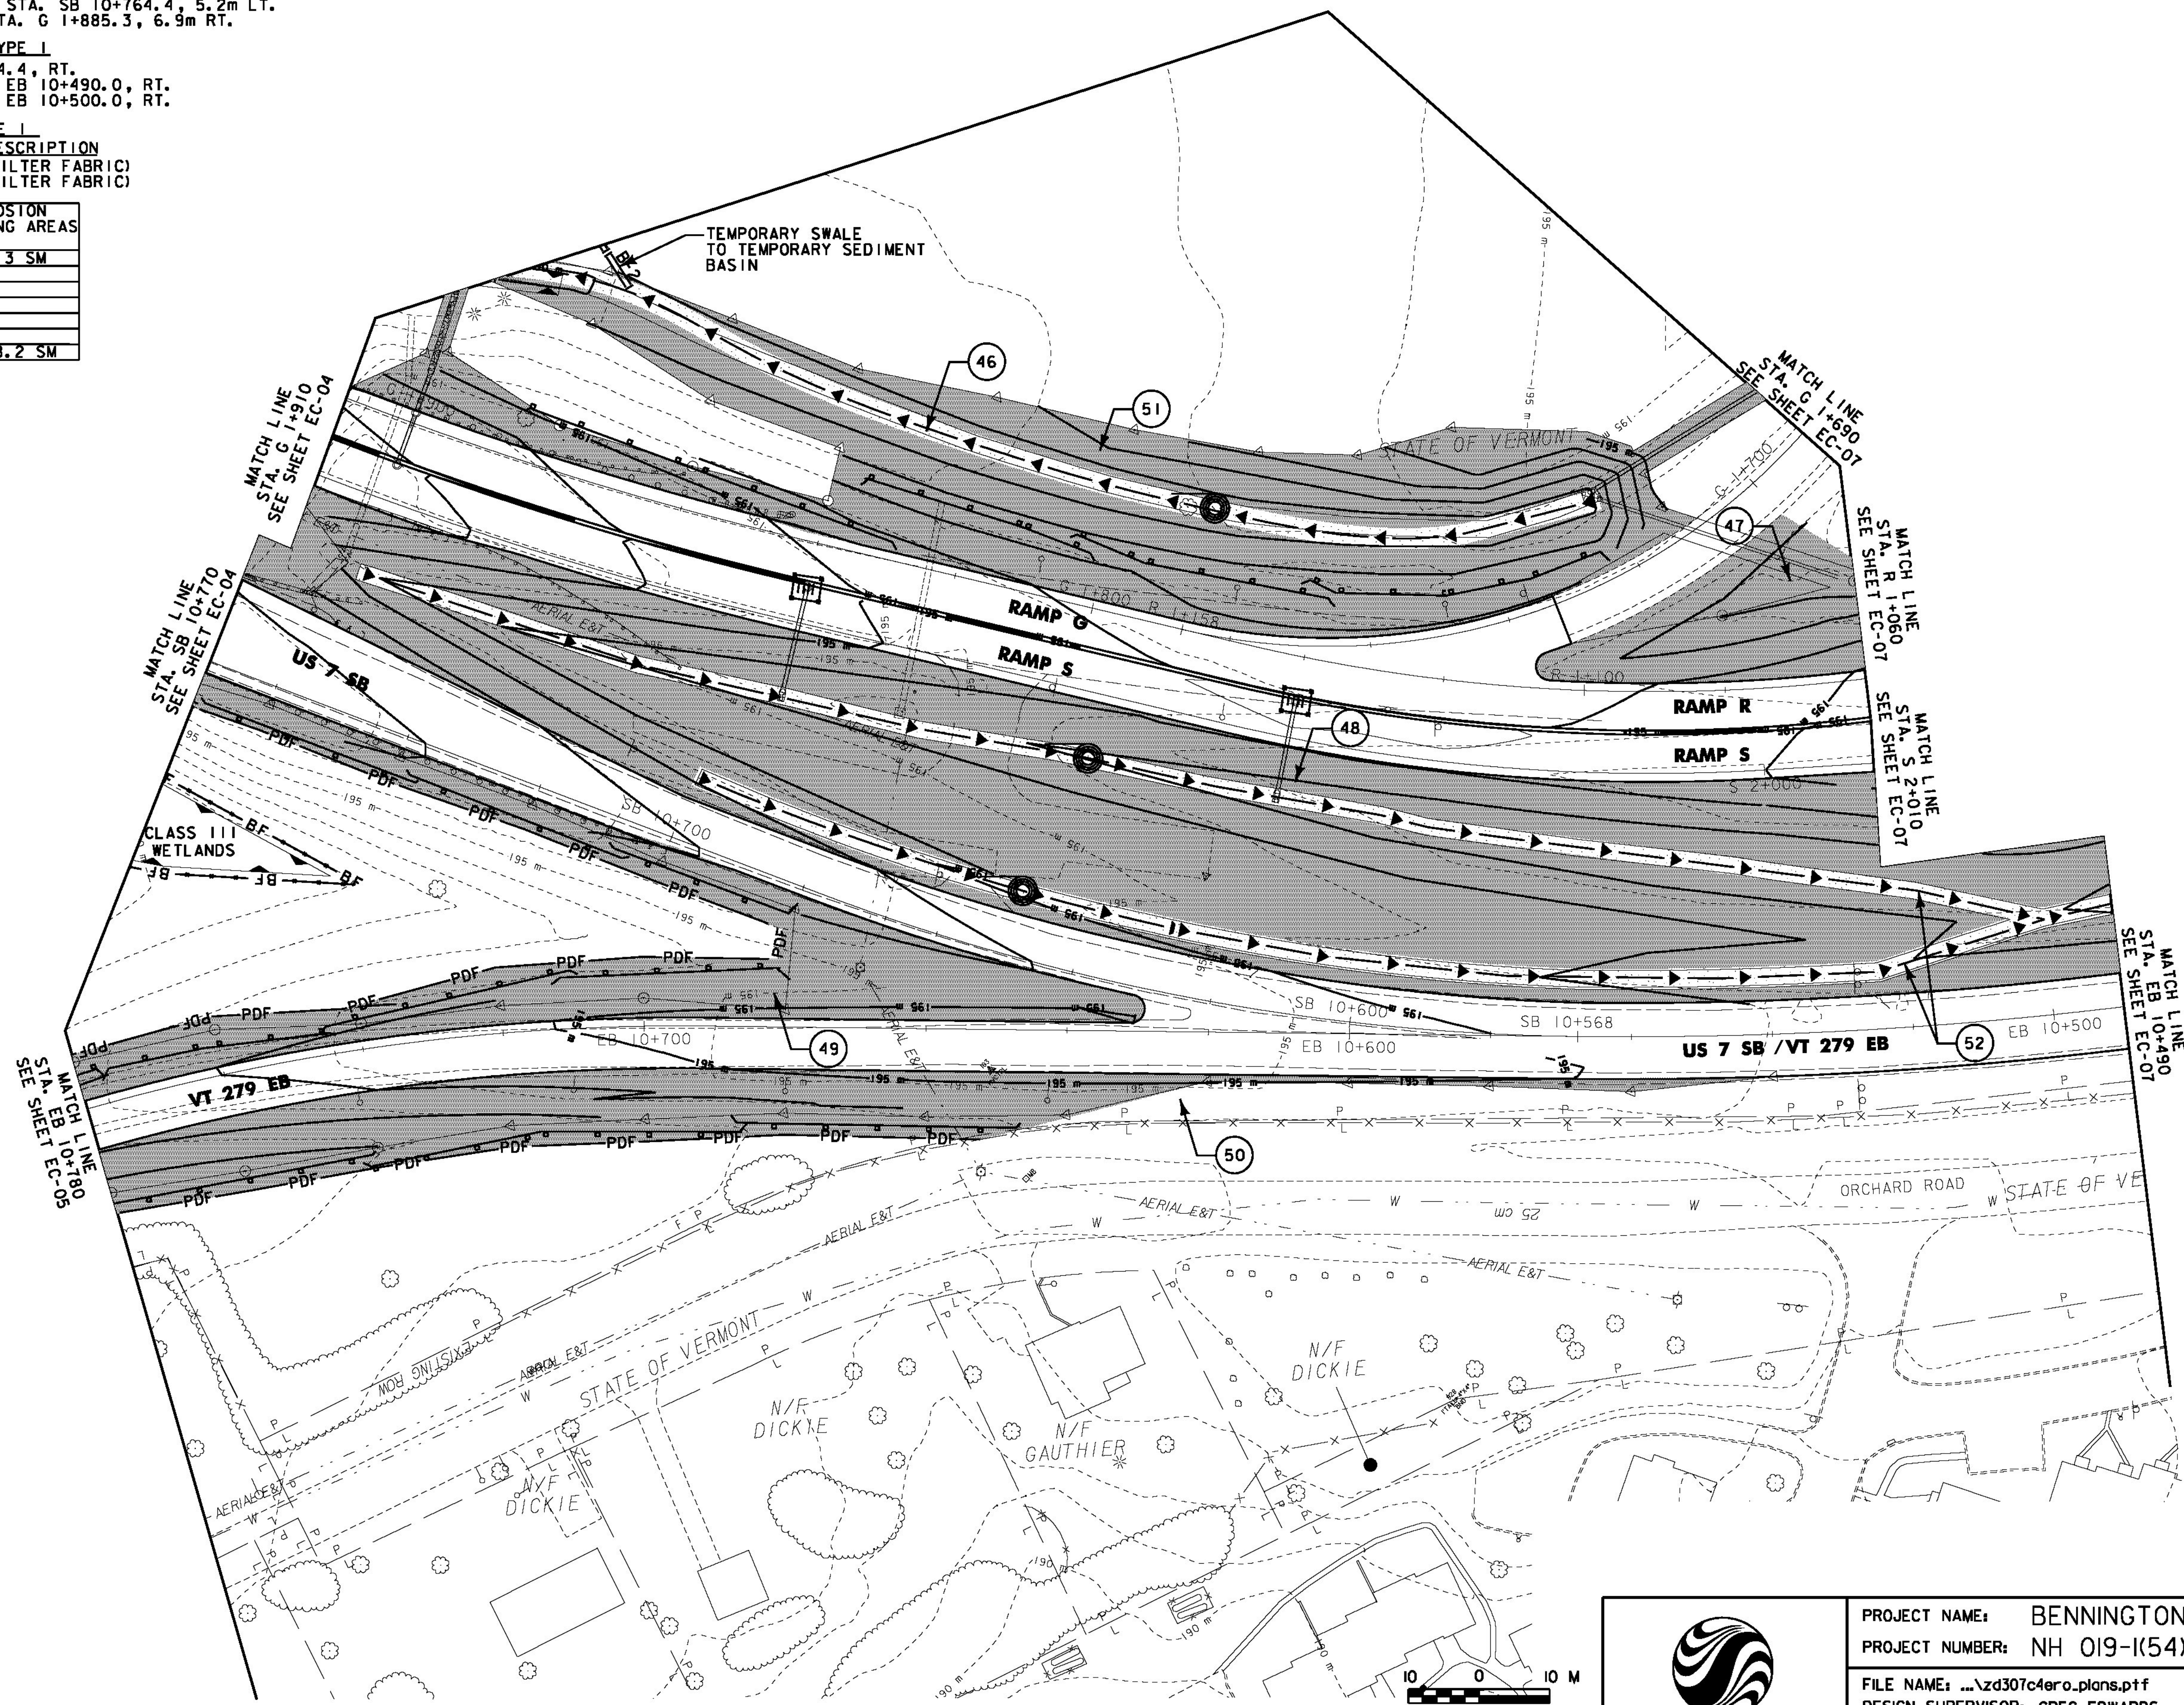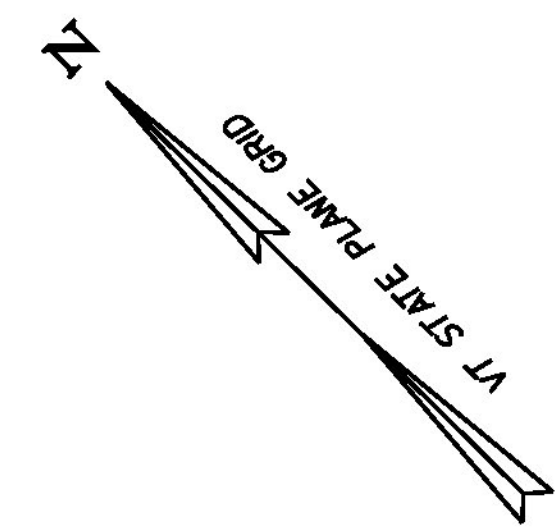

PROJECT NAME: BENNINGTON
 PROJECT NUMBER: NH 019-1(54)
 FILE NAME: ...zd307c4ero.plans.pft
 DESIGN SUPERVISOR: GREG EDWARDS
 DESIGNED BY: MARC FOISY
 EROSION CONTROL EC-06

PLOT DATE: 1/26/2010
 DRAWN BY: STANTEC
 CHECKED BY: GARY SANTY
 SHEET 155 OF 468

1/26/2010 4:56:14 PM v:\953\active\9531002\transportation\erom\ec\ec-06\ec-06.plans.pft