

DURABLE 150 WHITE LINE, RECESSED POLYUREA
 STA. EB 10+490.0 TO STA. EB 10+567.6, DASHED C
 STA. EB 10+490.0 TO STA. EB 10+780.0, SOLID LT.
 STA. G 1+733.0 TO STA. G 1+910.0, SOLID C
 STA. G 1+755.0 TO STA. G 1+910.0, SOLID LT.
 STA. G 1+755.0 TO STA. G 1+787.0, DOTTED LT.
 STA. R 1+060.0 TO STA. R 1+105.1, SOLID C
 STA. R 1+075.2 TO STA. R 1+124.8, SOLID LT.
 STA. S 2+000.0 TO STA. S 2+015.0, SOLID C
 STA. SB 10+630.8 TO STA. SB 10+770.0, SOLID C
 STA. G 1+757.0 TO STA. G 1+910.0, SOLID LT.

DURABLE 150 YELLOW LINE, RECESSED POLYUREA
 STA. EB 10+631.1 TO STA. EB 10+780.0, SOLID C
 STA. EB 10+490.0 TO STA. EB 10+567.6, SOLID RT.
 STA. EB 10+490.0 TO STA. EB 10+567.6, SOLID RT.
 STA. G 1+755.0 TO STA. G 1+910.0, SOLID LT.
 STA. G 1+755.0 TO STA. G 1+910.0, SOLID LT.
 STA. R 1+060.0 TO STA. R 1+124.8, SOLID LT.
 STA. R 1+060.0 TO STA. R 1+124.8, SOLID LT.
 STA. SB 10+567.6 TO STA. SB 10+770.0, SOLID RT.


MILLED RUMBLE STRIPS
 STA. EB 10+490.0, RT. - STA. SB 10+770.0, RT.
 STA. EB 10+490.0, LT. - STA. EB 10+780.0, LT.
 STA. EB 10+631.1, RT. - STA. EB 10+780.0, RT.
 STA. SB 10+630.8, RT. - STA. SB 10+770.0, RT.

DURABLE 300 WHITE LINE, RECESSED POLYUREA
 STA. EB 10+567.6 TO STA. EB 10+631.1, C & RT. (GORE)
 STA. G 1+736.6 TO STA. G 1+755.0, LT. (GORE)

REMOVING SIGNS
 AS SHOWN - II

DURABLE LETTER OR SYMBOL, THERMOPLASTIC
 STA. R 1+089.0, LT. - "HEAD"
 STA. R 1+101.0, LT. - "HEAD"
 STA. R 1+103.0, LT. - "VVVV"


OVERHEAD SIGN ASSEMBLY - MULTI-SUPPORT
 STA. EB 10+490.0

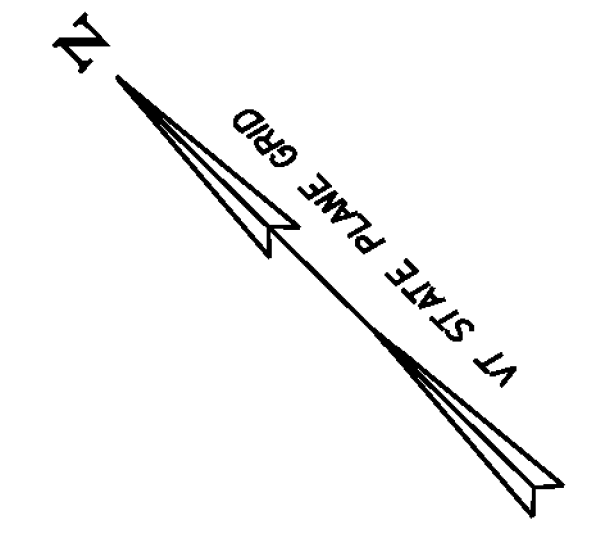


DELINEATOR WITH STEEL POST

ROADWAY	LENGTH (m)	SPACING (m)	COLOR	TYPE
VT 279 EB				
EB 10+490.0, LT - EB 10+780.0, LT	290	80.5	WHITE	I
EB 10+631.1, RT - EB 10+780.0, RT	149	80.5	YELLOW	I
RAMP G				
G 1+787.0, RT - G 1+844.1, RT	57	30.5	WHITE	I
G 1+844.1, LT - G 1+910.0, LT	66	30.5	YELLOW	I
RAMP R				
R 1+060.0, LT - R 1+148.6, LT	89	24.4	YELLOW	I
RAMP S				
G 1+772.7, LT - G 1+910.0, LT	137	30.5	WHITE	I
G 1+772.7, LT - S 2+015.0, RT	90	24.4	WHITE	I
US 7 SB				
EB 10+490.0, RT - SB 10+770.0, RT	280	80.5	YELLOW	I
SB 10+630.8, LT - SB 10+770.0, LT	139	80.5	WHITE	I


FOR FURTHER INFORMATION, SEE VTRANS STANDARD E-197

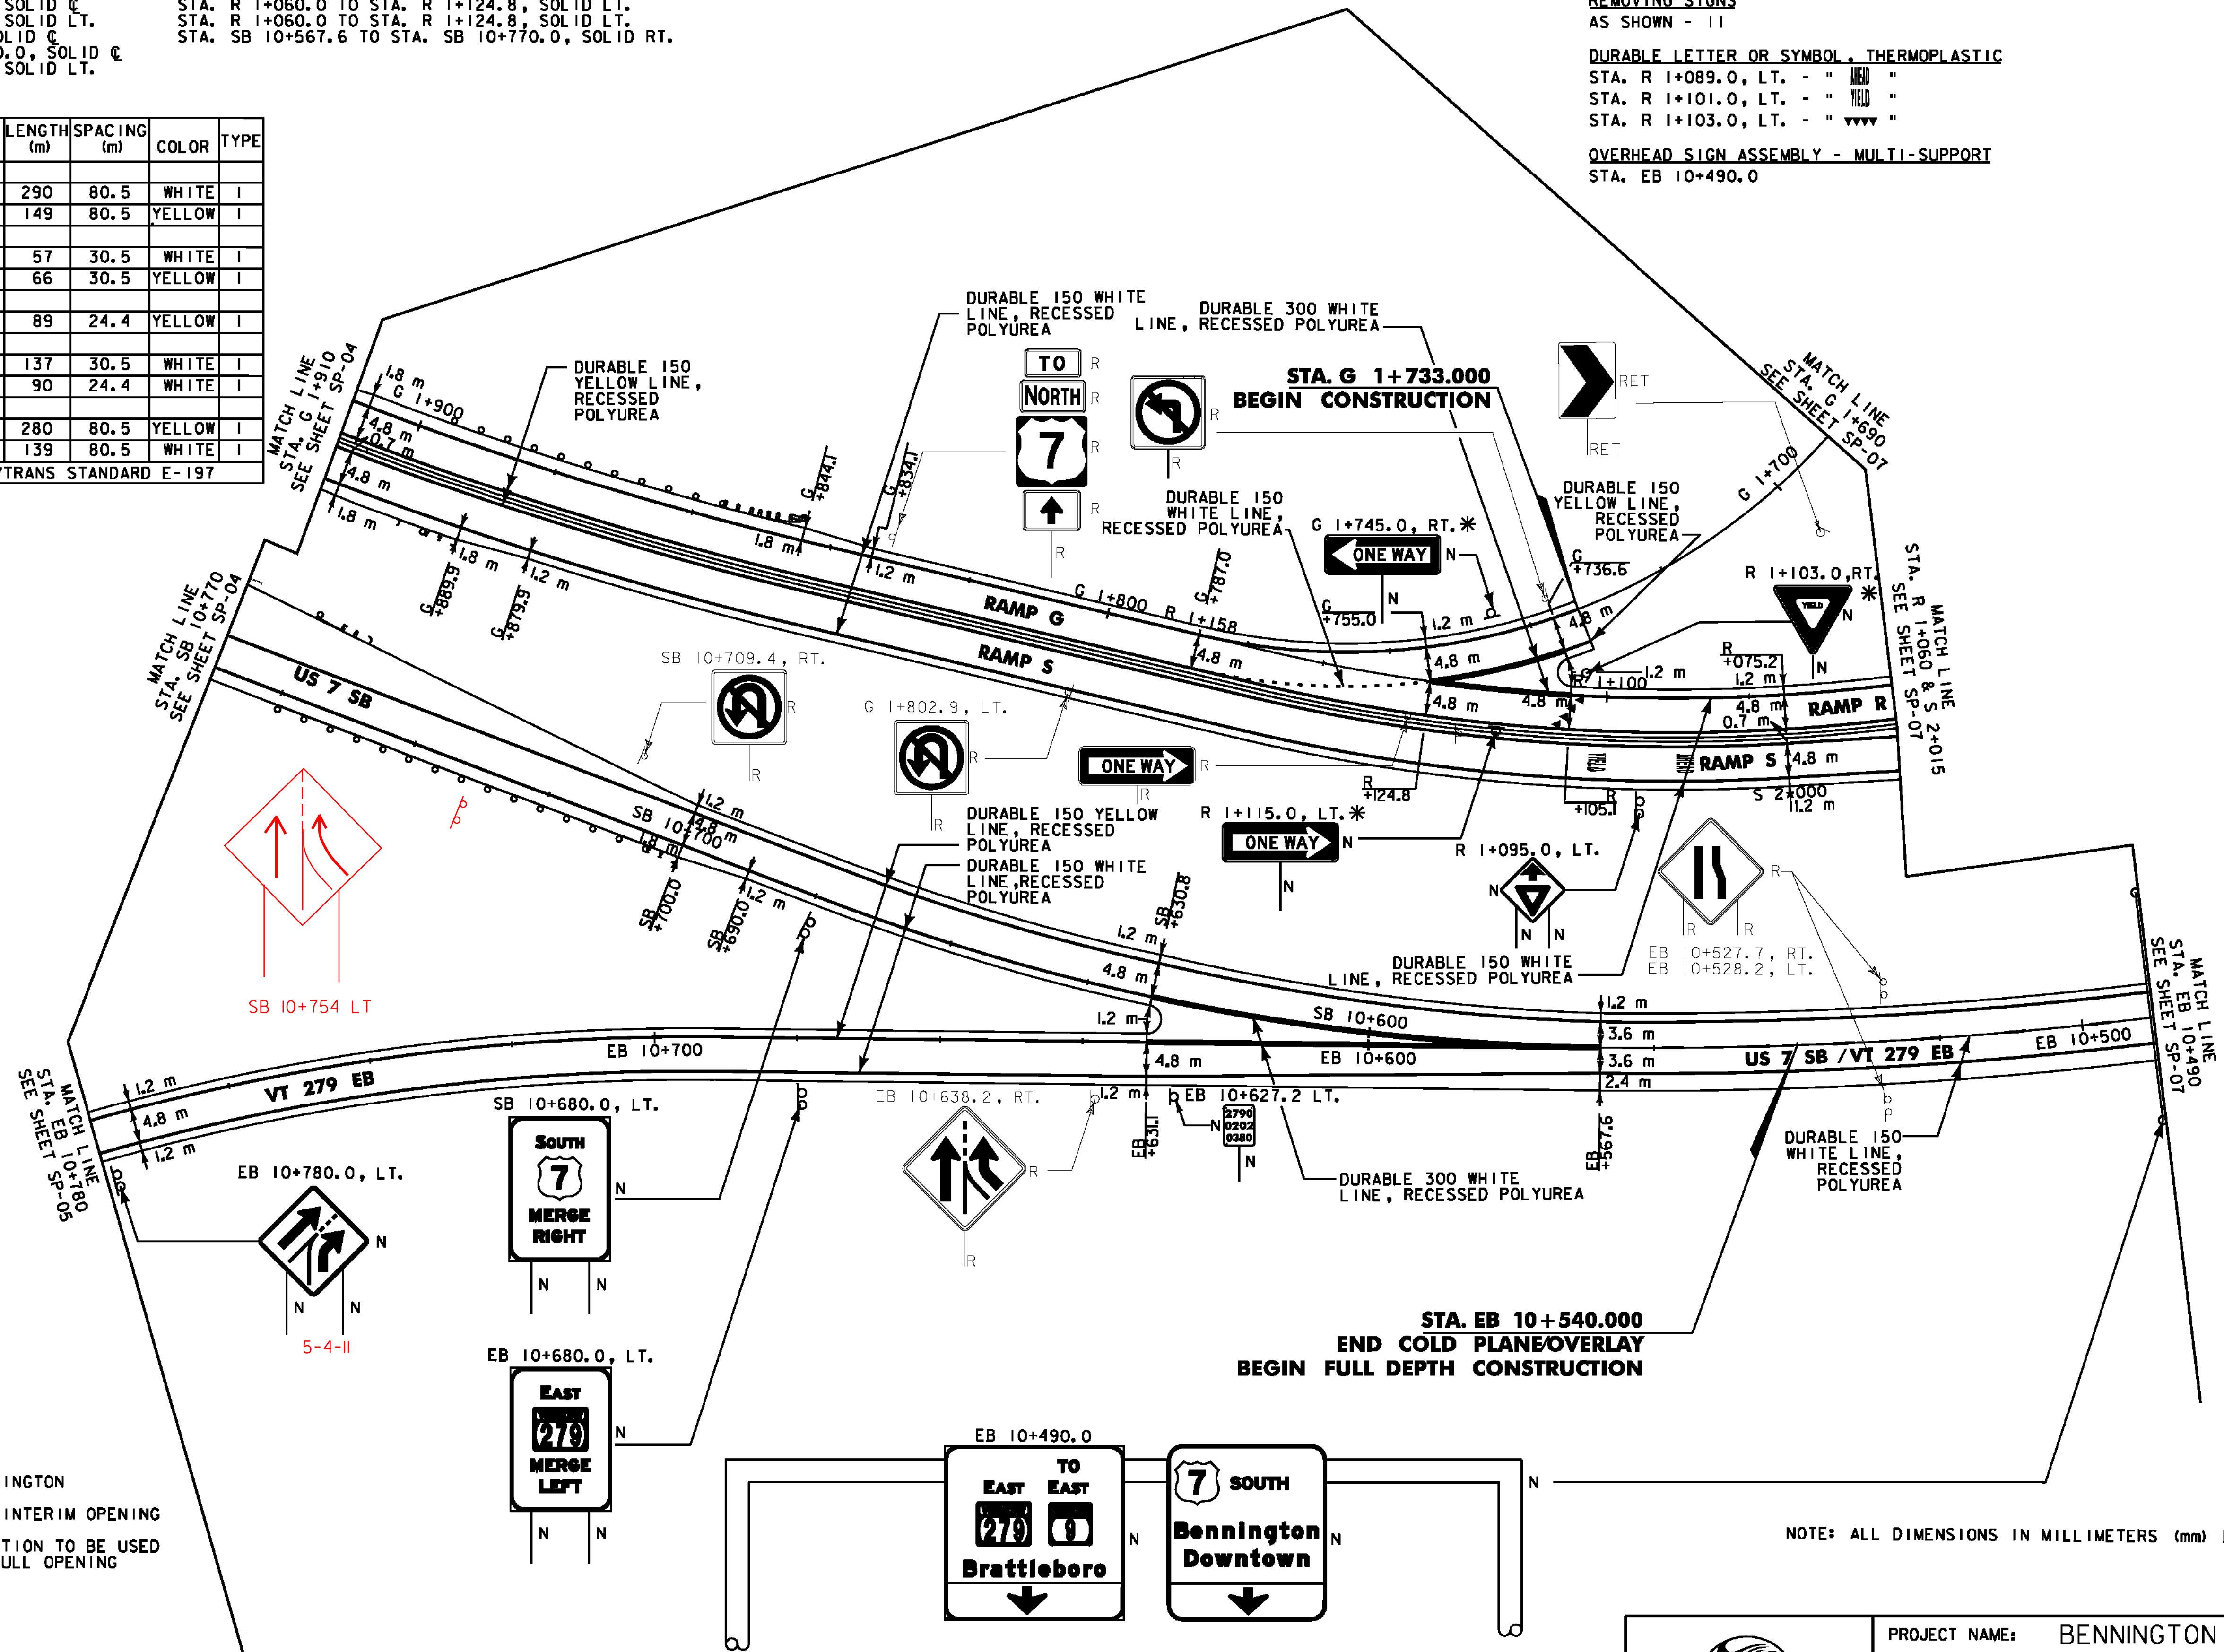

- SIGN LEGEND**
- N = NEW
 - R = REMOVE
 - R&S = REMOVE & SALVAGE
 - S = SALVAGE SIGN
 - RET = RETAIN
 - ♣ = NEW SIGN & POST
 - ⊙ = RETURN TO TOWN OF BENNINGTON
 - * = SIGN NOT REQUIRED FOR INTERIM OPENING
 - ** = SIGN REQUIRES MODIFICATION TO BE USED BETWEEN INTERIM AND FULL OPENING

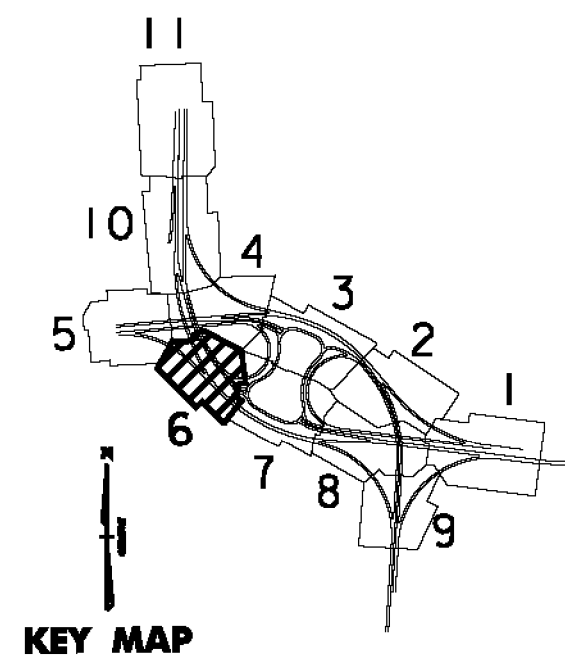

NOTE: ALL DIMENSIONS IN MILLIMETERS (mm) EXCEPT WHERE NOTED

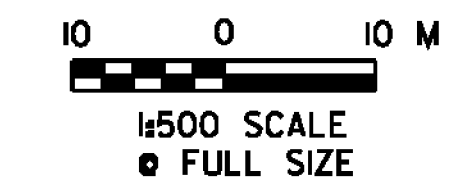

PROJECT NAME: BENNINGTON
 PROJECT NUMBER: NH 019-(K54)
 FILE NAME: ...z307c4sgnpvm_plans.pfl
 DESIGN SUPERVISOR: GREG EDWARDS
 DESIGNED BY: MARC FOISY
 SIGNS AND MARKINGS SP-06
 PLOT DATE: 1/26/2010
 DRAWN BY: STANTEC
 CHECKED BY: GARY SANTY
 SHEET 178 OF 468

1/26/2010 4:50:36 PM v:\1953\getlive\19530002\tr\anspor\ref\ion\dr\awing\com\tr\cst_4\p\ot_4\files\z307c4sgnpvm_plans.pfl