


1/26/2010 4:57:21 PM v:\953\active\9531002\transportation\grawma\contract\4\bid\files\z307c4tcp-det.plt

**LEGEND**

- = WORK AREAS
- = TRAFFIC FLOW

**ONSITE TRAFFIC CONTROL DURING CONSTRUCTION  
PHASE 3  
DETAIL 2**

- US7 NB**
- SWITCH OVER TRAFFIC & BARRIERS ON NB TO START
  - CONSTRUCT STA LT. NB
  - ON WB, SWITCH TRAFFIC BACK ONTO STA. RT.
  - CONSTRUCT STA. LT. WB, DISMANTELING TEMPORARY WIDENING

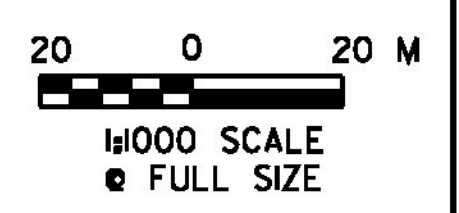

PROJECT NAME: BENNINGTON	
PROJECT NUMBER: NH 019-1(54)	
FILE NAME: ...\plot_files\z307c4tcp-det.plt	PLOT DATE: 1/26/2010
DESIGN SUPERVISOR: GREG EDWARDS	DRAWN BY: STANTEC
DESIGNED BY: MARC FOISY	CHECKED BY: GARY SANTY
TRAFFIC CONTROL PLANS TC-08	SHEET 246 OF 468