


US ROUTE 7 SOUTH DETOUR

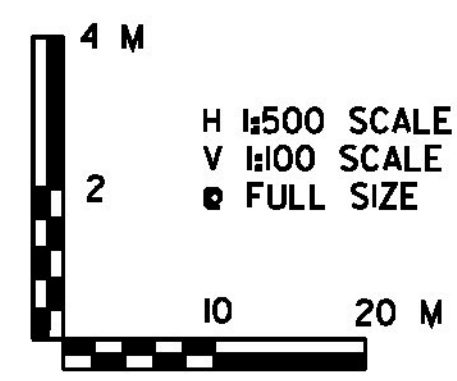

PROJECT NAME:	BENNINGTON	PLOT DATE:	1/26/2010
PROJECT NUMBER:	NH 019-1(54)	DRAWN BY:	STANTEC
FILE NAME:	...\\plot_files\zd307c4pro.TC.ptf	CHECKED BY:	GARY SANTY
DESIGN SUPERVISOR:	GREG EDWARDS	TRAFFIC CONTROL PLANS TC-11	SHEET 249 OF 468
DESIGNED BY:	MARC FOISY		

1/26/2010 4:53:24 PM v:\953\active\953002\transportation\rdw\m\scott\tracet_4\blot_files\zd307c4pro.TC.ptf