


US ROUTE 279 DETOUR

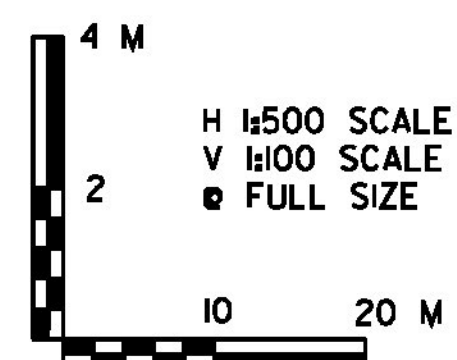

PROJECT NAME:	BENNINGTON
PROJECT NUMBER:	NH 019-1(54)
FILE NAME:	...\\plot_files\zd307c4pro.TC.ptf
DESIGN SUPERVISOR:	GREG EDWARDS
DESIGNED BY:	MARC FOISY
TRAFFIC CONTROL PLANS:	TC-12
PLOT DATE:	1/26/2010
DRAWN BY:	STANTEC
CHECKED BY:	GARY SANTY
SHEET:	250 OF 468

1/26/2010 4:55:25 PM v:\953\active\953002\transportation\bennington\contract\4\plot_files\zd307c4pro.TC.ptf