


EXISTING BRIDGE SECTION
SCALE 1/40

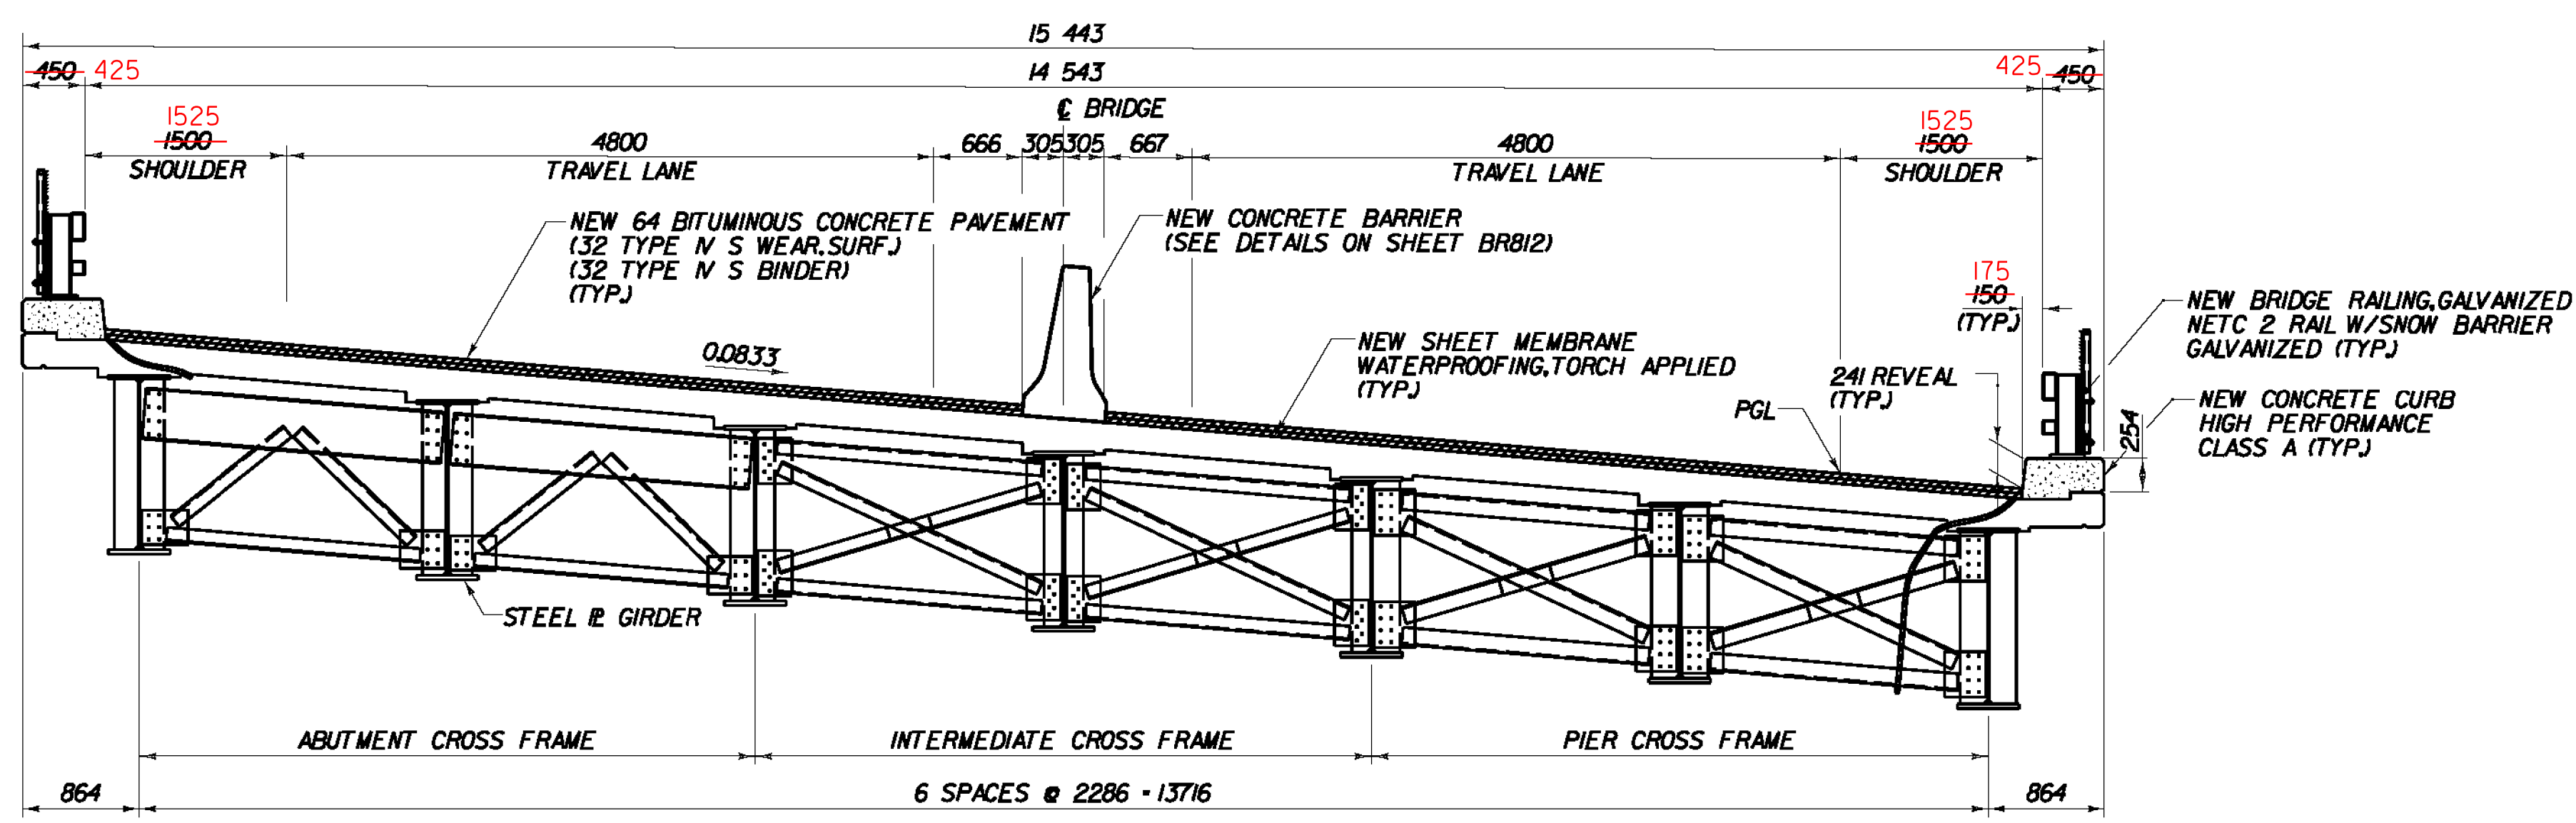

PROPOSED BRIDGE SECTION
SCALE 1/40

- NOTES:
- EXISTING STEEL MEMBERS TO BE CLEANED AND PAINTED. SEE SHEET BR806.
 - ALL HORIZONTAL DIMENSIONS ARE RADIAL.

**STATE OF VERMONT
AGENCY OF TRANSPORTATION**

Town Of	BENNINGTON	Bridge No.	14A
Highway No.		Log Sta.	
		Surv. Sta.	
RAMP G/S OVER VT ROUTE 279 WB			
TYPICAL BRIDGE SECTIONS			
Designed By	M. CHENETTE	Drawn By	A. THIBAUT
Checked By	M. CHENETTE	Date	11/09
		Bridge Design Supervisor	G. BOGUE
PROJECT	BENNINGTON	Date	11/09
		PROJECT NO.	NH FO19-1(54)



1/26/2010 4:54:15 PM v:\1953\get\1va\1953\002\str\str\cur\design\st\1\plot - files\801-SI\BR801-TypSec.dwg