


EXISTING BRIDGE SECTION
SCALE 1/40

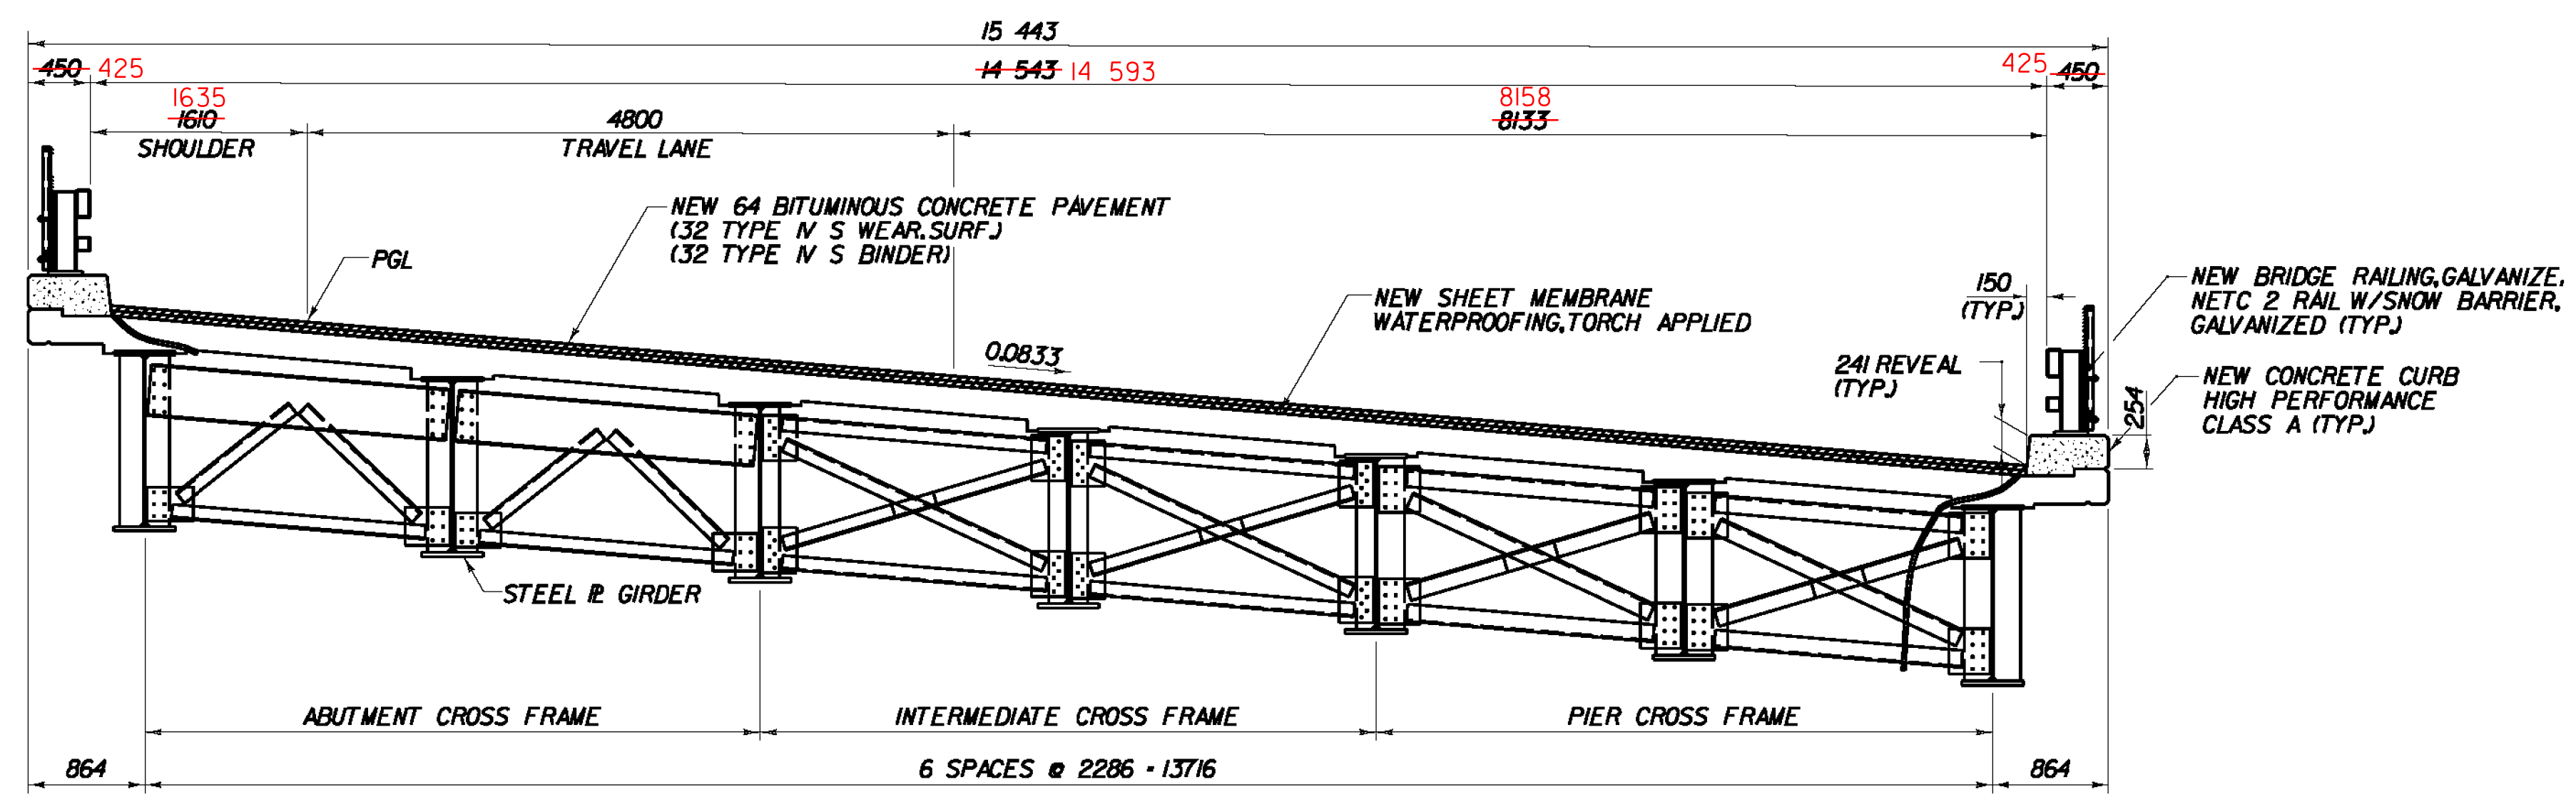

PROPOSED BRIDGE SECTION
SCALE 1/40

- NOTES:
- EXISTING STEEL MEMBERS TO BE CLEANED AND PAINTED. SEE SHEET BR906.
 - ALL DIMENSIONS ARE RADIAL.

| STATE OF VERMONT AGENCY OF TRANSPORTATION | | | |
|--|-------------|--------------------------|------------------------------|
| Town Of | BENNINGTON | Bridge No. | 145 |
| Highway No. | Log Sta. | | Surv. Sta. |
| US ROUTE 7 SB OVER VT ROUTE 279 WB | | | |
| TYPICAL BRIDGE SECTIONS | | | |
| Designed By | M. CHENETTE | Drawn By | A. THIBAUT |
| Checked By | M. CHENETTE | Date | 11/09 |
| | | Bridge Design Supervisor | G. BOGUE |
| | | Date | 11/09 |
| PROJECT | BENNINGTON | | PROJECT NO. NH F019-1(54) |
| I.G.C. info | | Sheet 295 of 468 | |
| Bridge Sheet No. BR901 | | | |



1/26/2010 4:55:08 PM v:\1953\get\1va\1953\0002\struc\cur\design\st\typ\brt - files\30-11758-typrsec.dwg