


NOTE: ALL DIMENSIONS RADIAL ALONG FACE OF RAIL



**STATE OF VERMONT  
AGENCY OF TRANSPORTATION**

Town Of	BENNINGTON	Bridge No.	145
Highway No.		Log Sta.	
		Surv. Sta.	
US ROUTE 7 SB OVER VT ROUTE 279 WB			
<b>REINFORCEMENT AND RAILING PLAN</b>			
Designed By	E. ALLING	Drawn By	T. KNIGHT
Checked By	M. CHENETTE	Date	11/09
		Bridge Design Supervisor	G. BOGUE
PROJECT	BENNINGTON	Date	11/09
		PROJECT NO.	NH F019-(154)

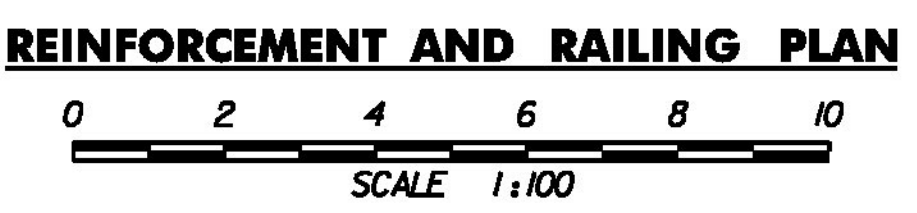

I:\25\2800\_4455\44 PM v\1953\active\19530022\structure\design\brg1\brg1.dwg - 11/11/09 10:11:11 AM