



WB 9+680

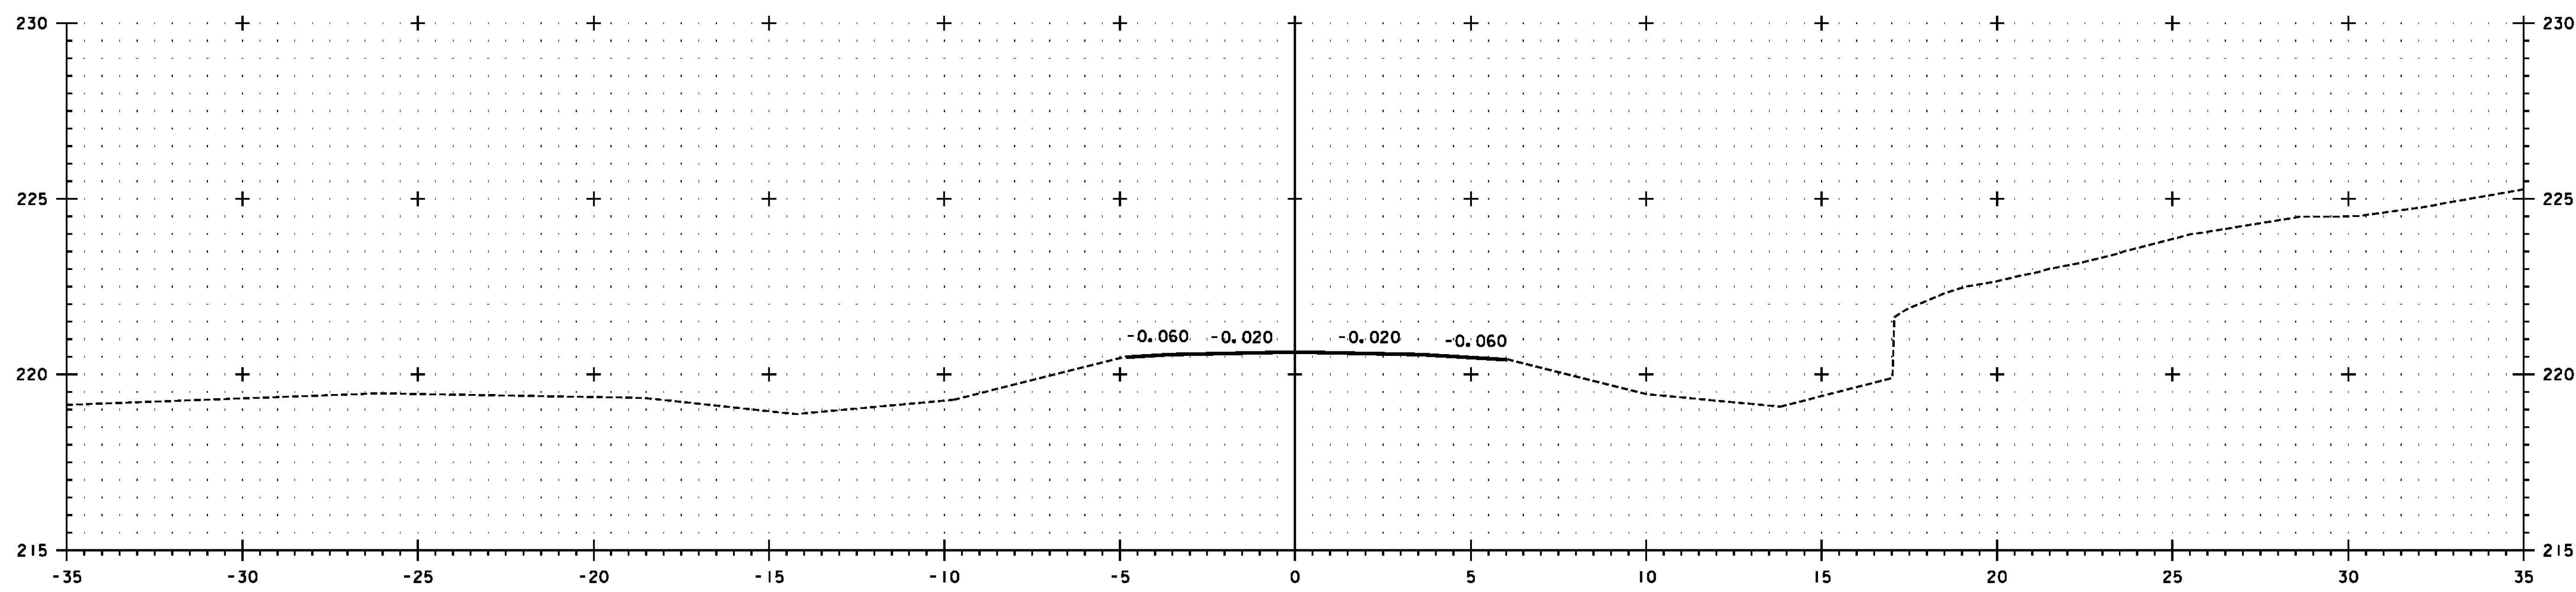

WB 9+664.846
BEGIN APPROACH

NOTE: FINAL CROSS SECTIONS FOR WB ARE CONTAINED IN THE FINAL COMP BOOKS FOR ITEM 203.15 - COMMON EXCAVATION

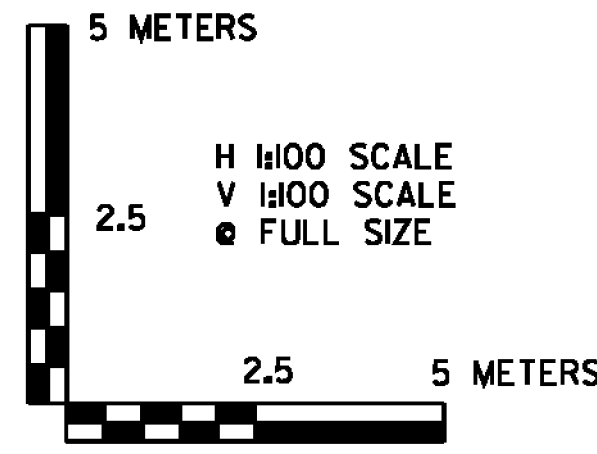

SEE REVISED



PROJECT NAME:	BENNINGTON
PROJECT NUMBER:	NH 019-(154)
FILE NAME:	...plot_files\zd307c4xs.279WB.ptf
DESIGN SUPERVISOR:	GREG EDWARDS
DESIGNED BY:	MARC FOISY
VT 279 WB CROSS SECTION WBX-01	
PLOT DATE:	1/26/2010
DRAWN BY:	STANTEC
CHECKED BY:	GARY SANTY
SHEET	312 OF 468

1/26/2010 4:55:56 PM V:\1953\getlive\1953\002A\tramsport\station\dr\cwg\ng\constr\cst_4\plot_files\zd307c4xs.279WB.ptf