



WB 9+680

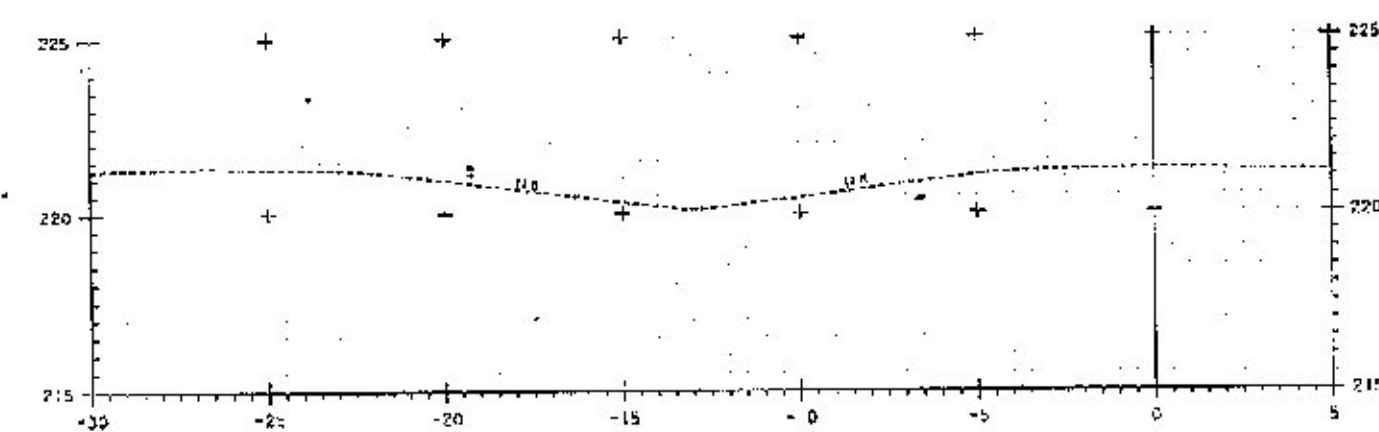

WB 9+660

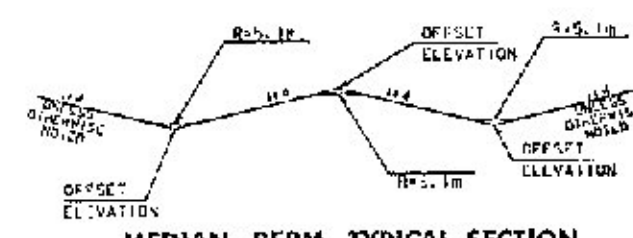

MEDIAN BERM TYPICAL SECTION

NOTE:
ELEVATIONS SHOWN DO NOT TAKE INTO ACCOUNT
THE 5.18 ROUNDING OF THE DITCH OR BERM.

Record Plans