



WB 9+769.989=
POB F 1+000.000

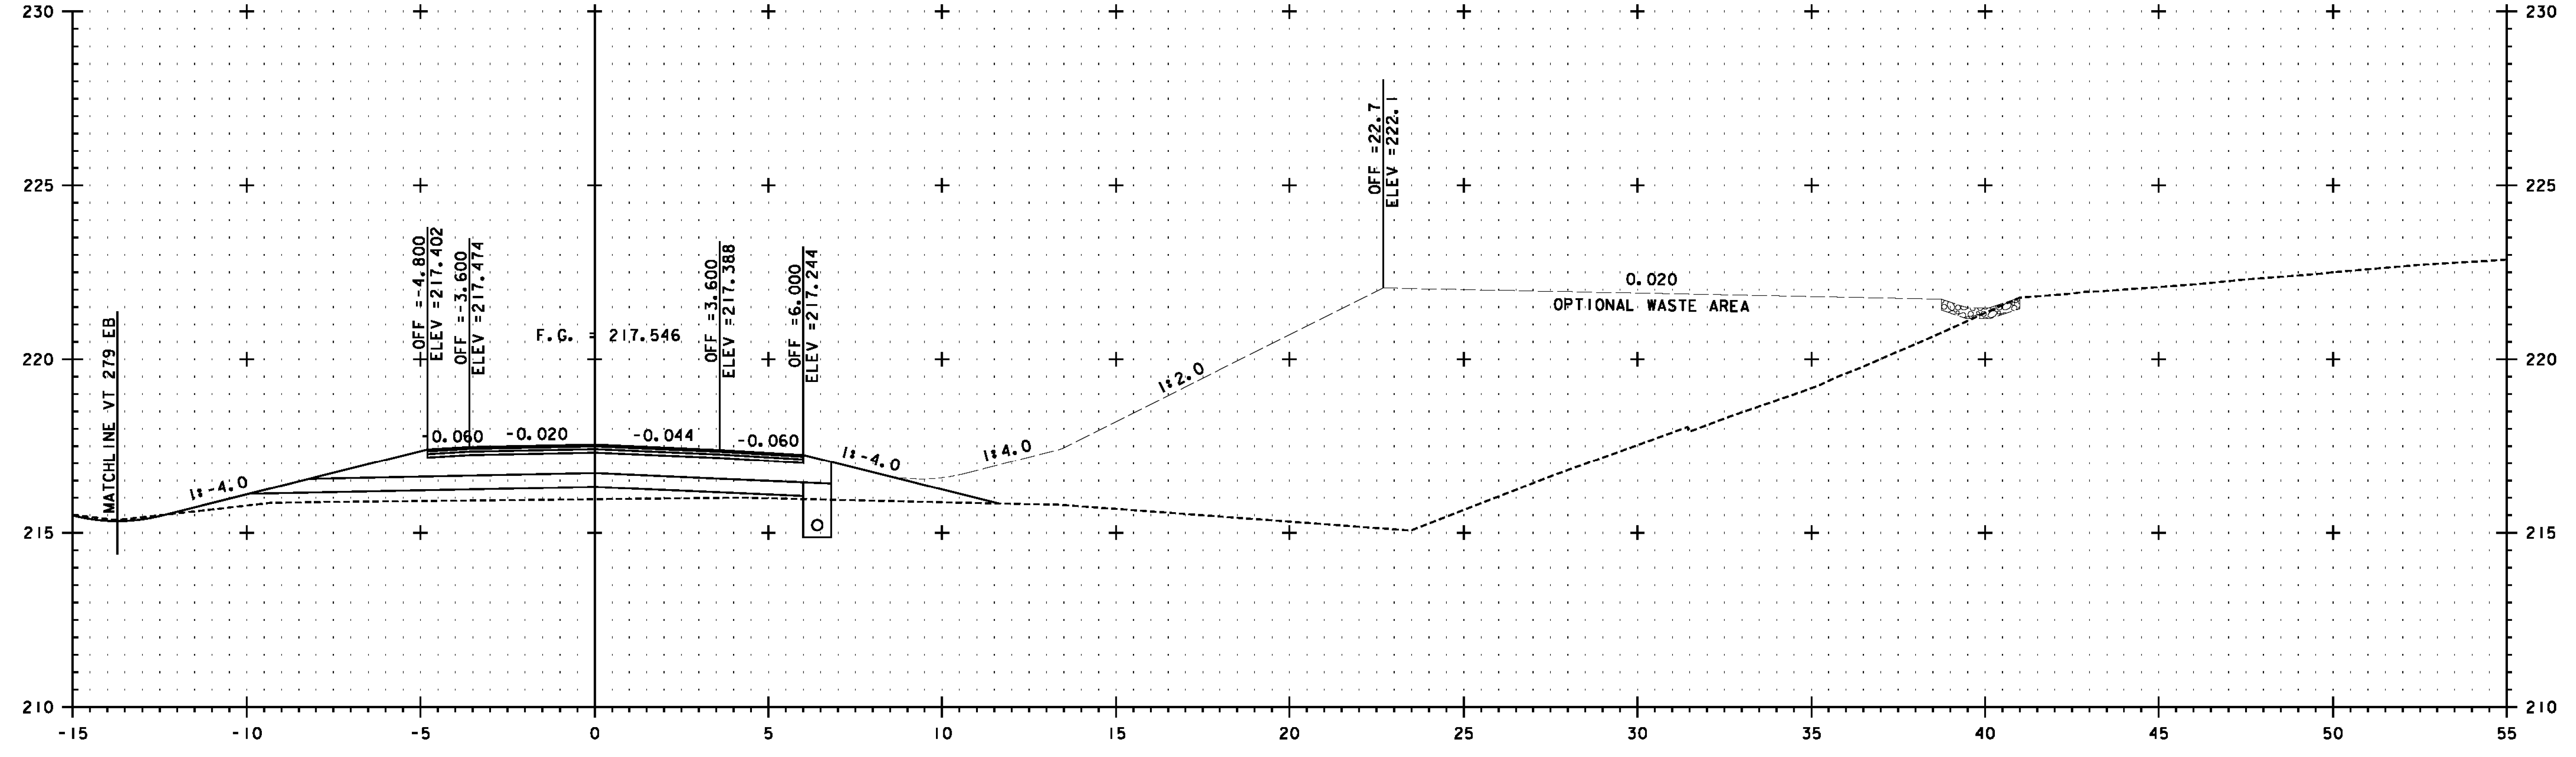


WB 9+760

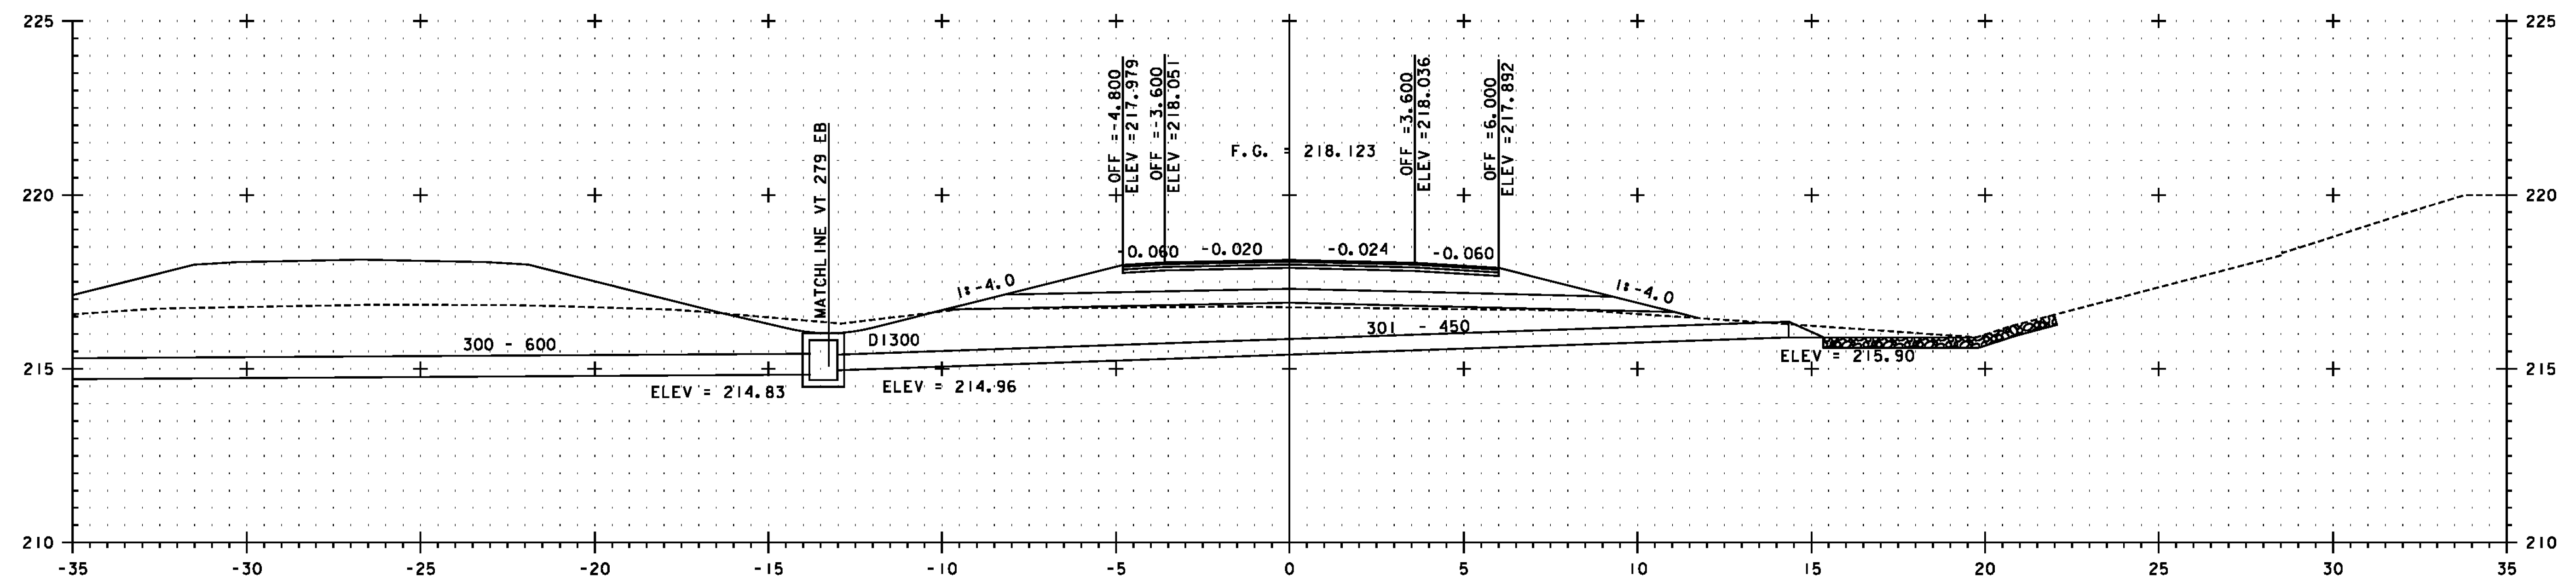

WB 9+740

SEE NOTE ON SHEET 312

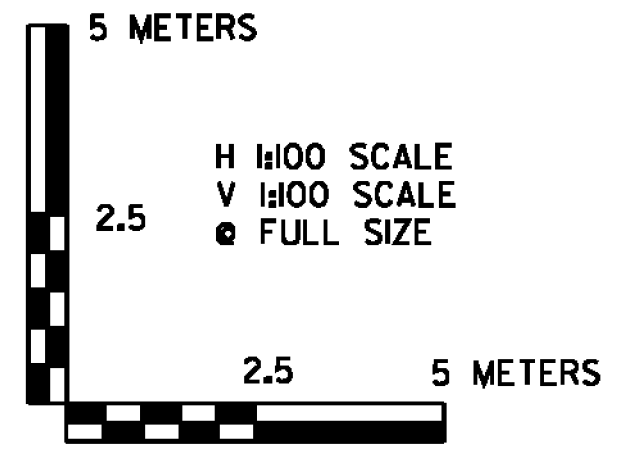

SEE REVISED	
PROJECT NAME:	BENNINGTON
PROJECT NUMBER:	NH 019-(154)
FILE NAME:	...plot_files\zd307c4xs.279WB.ptf
DESIGN SUPERVISOR:	GREG EDWARDS
DESIGNED BY:	MARC FOISY
VT 279 WB CROSS SECTION	WBX-03
PLOT DATE:	1/26/2010
DRAWN BY:	STANTEC
CHECKED BY:	GARY SANTY
SHEET 314 OF 468	

1/26/2010 4:55:58 PM v:\1953\getlive\19530002\transportation\drawing\comfr\001_4\plot_files\zd307c4xs.279WB.ptf