


SEE NOTE ON SHEET 312

WB 9+780

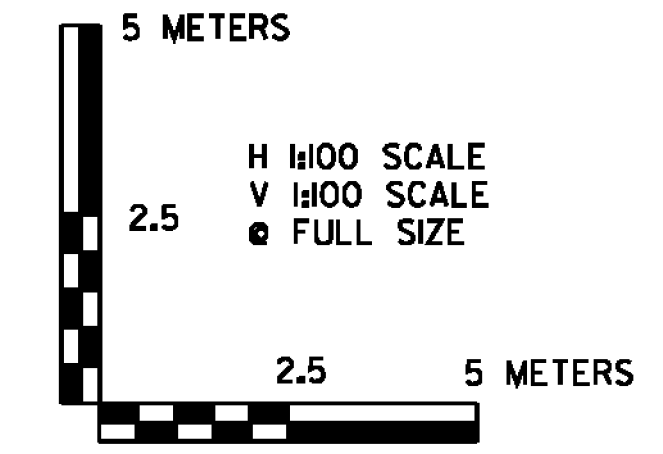

SEE REVISED

	PROJECT NAME: BENNINGTON
	PROJECT NUMBER: NH 019-1(54)
FILE NAME: ...\plot_files\zd307c4xs.279WB.ptf	PLOT DATE: 1/26/2010
DESIGN SUPERVISOR: GREG EDWARDS	DRAWN BY: STANTEC
DESIGNED BY: MARC FOISY	CHECKED BY: GARY SANTY
VT 279 WB CROSS SECTION WBX-04	SHEET 315 OF 468

1/26/2010 4:55:59 PM v:\1953\getlive\19530002A\transportation\drw\mg\confr\cst\_4\plot\_files\zd307c4xs.279WB.ptf