


WB 9+840

SEE NOTE ON SHEET 312

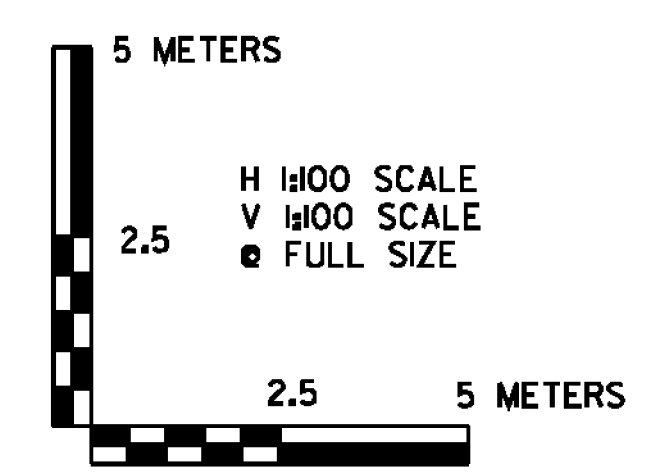

SEE REVISED

	PROJECT NAME: BENNINGTON
	PROJECT NUMBER: NH 019-(154)
	FILE NAME: ...\plot_files\zd307c4xs.279WB.ptf PLOT DATE: 1/26/2010 DESIGN SUPERVISOR: GREG EDWARDS DRAWN BY: STANTEC DESIGNED BY: MARC FOISY CHECKED BY: GARY SANTY VT 279 WB CROSS SECTION WBX-06 SHEET 317 OF 468